
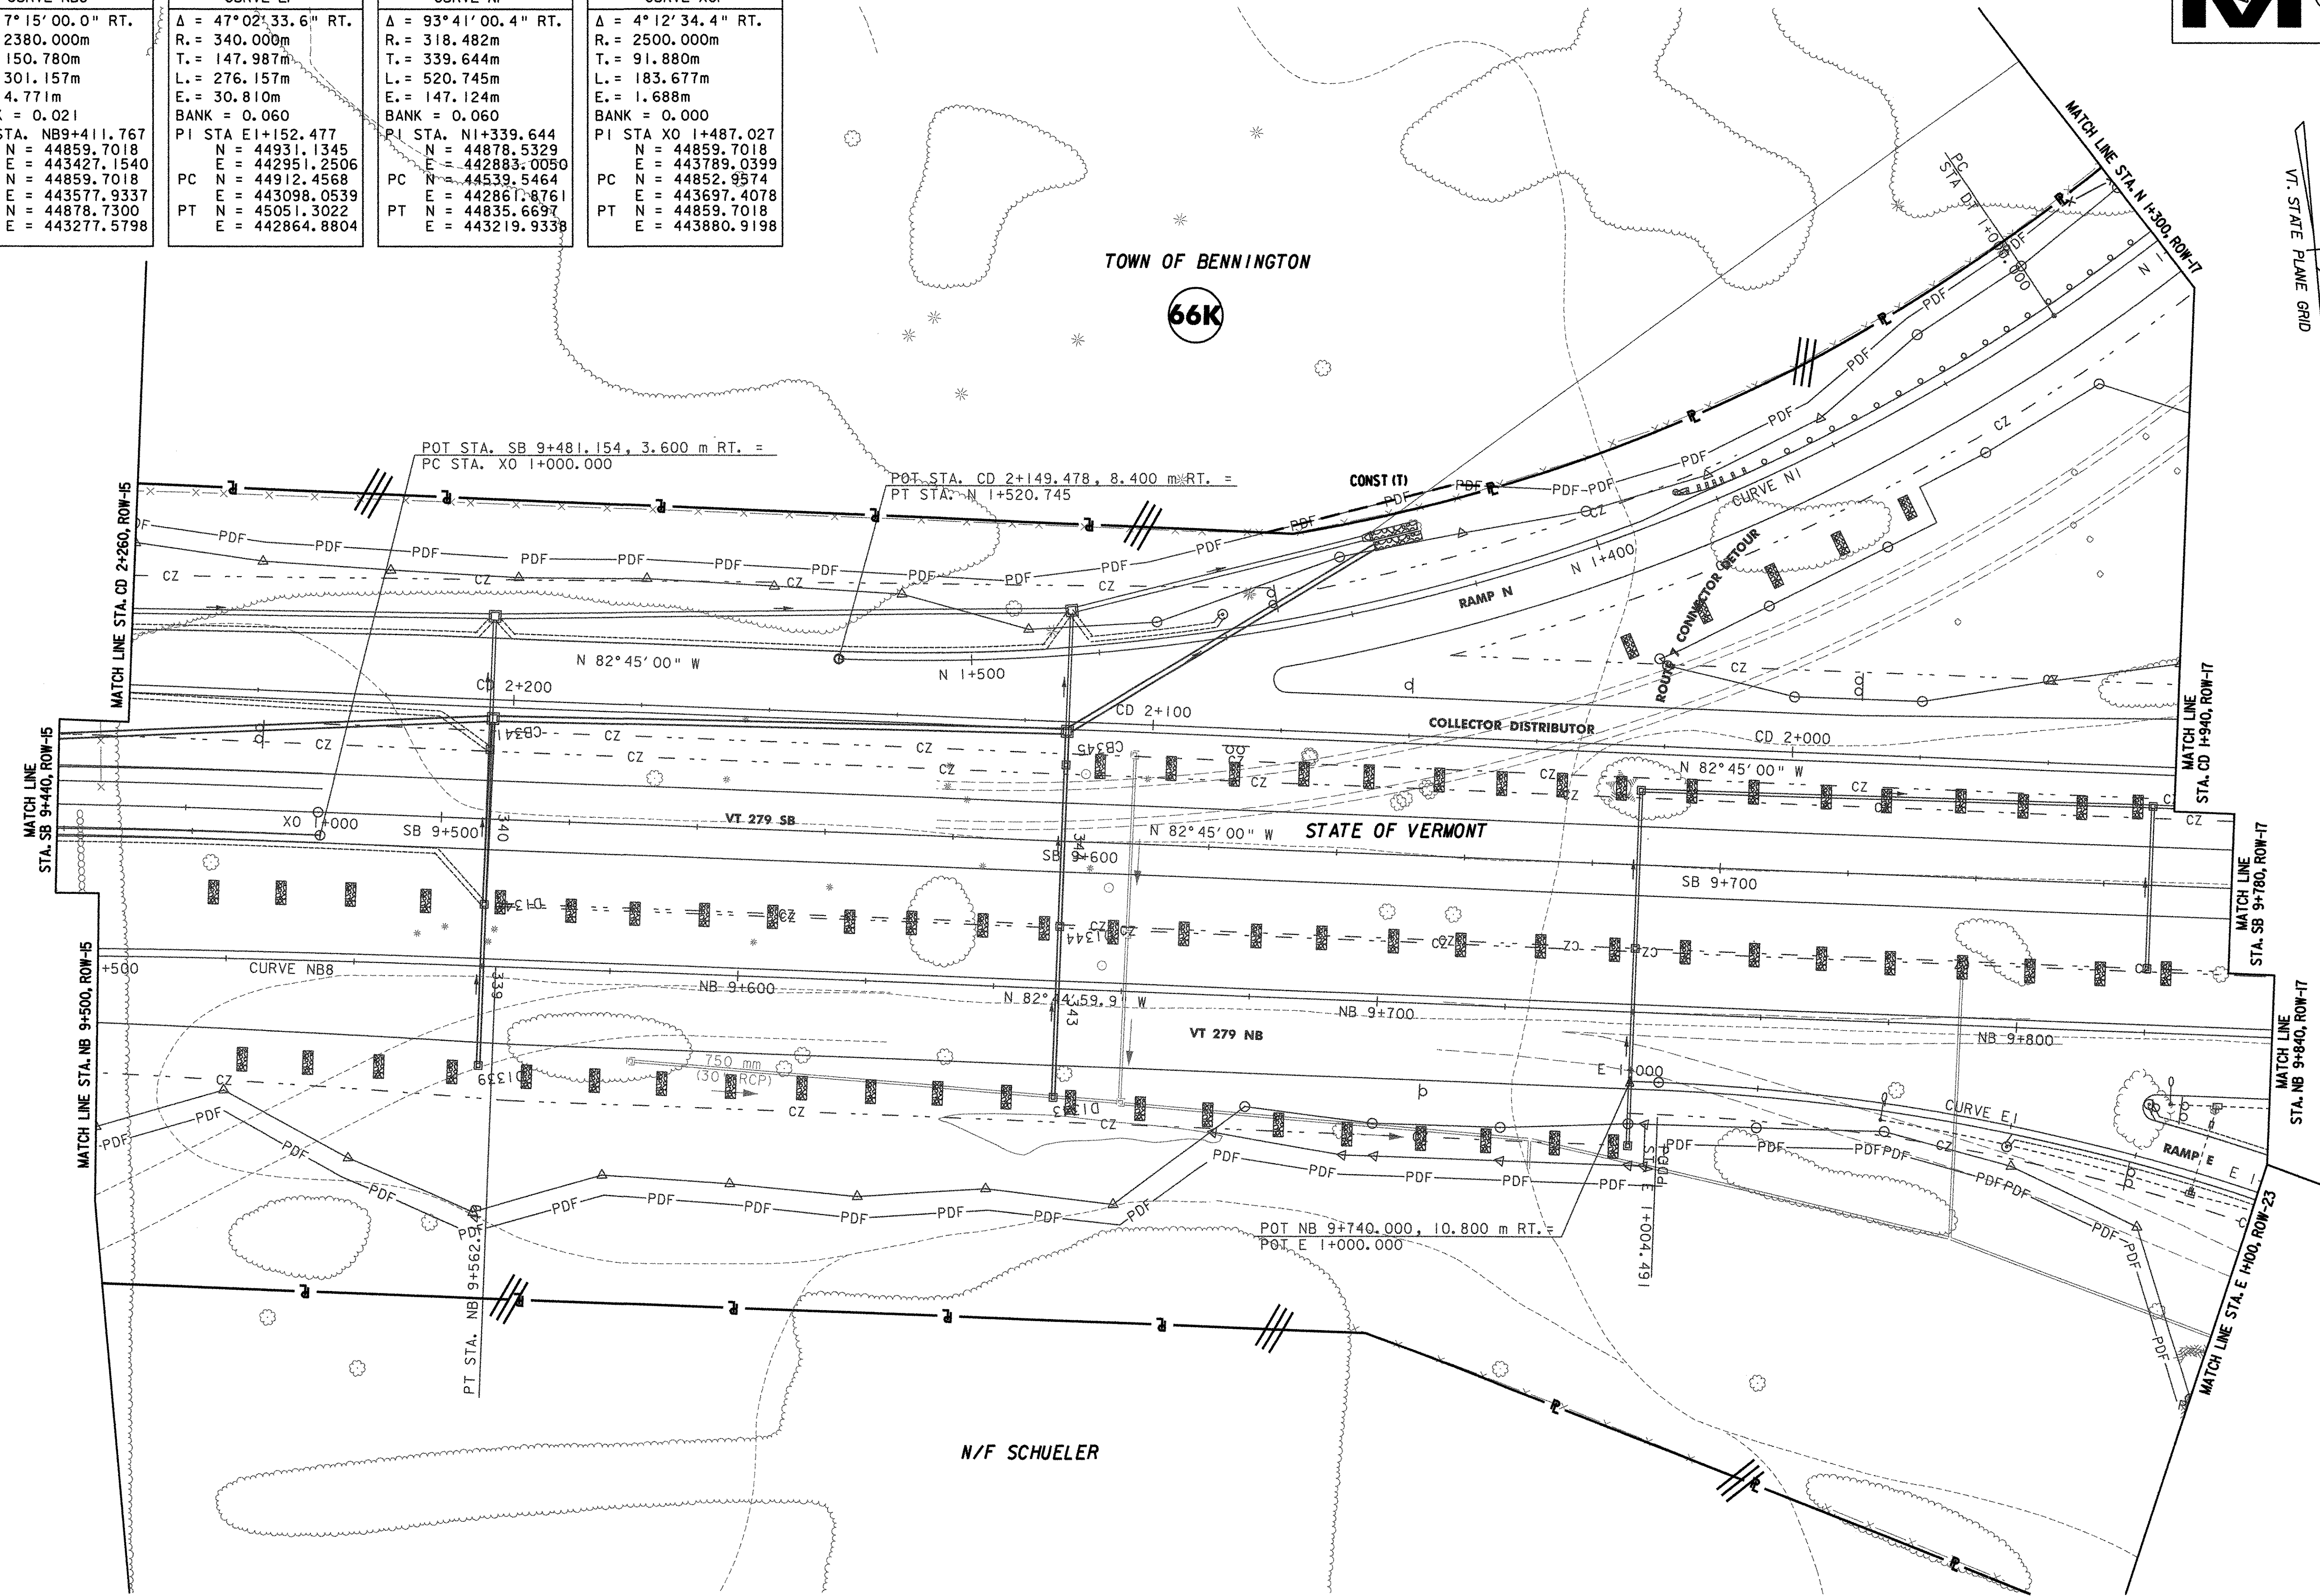


CURVE NB8	CURVE EI	CURVE NI	CURVE XO1
$\Delta = 7^{\circ}15'00.0''$ RT.	$\Delta = 47^{\circ}02'33.6''$ RT.	$\Delta = 93^{\circ}41'00.4''$ RT.	$\Delta = 4^{\circ}12'34.4''$ RT.
R. = 2380.000m	R. = 340.000m	R. = 318.482m	R. = 2500.000m
T. = 150.780m	T. = 147.987m	T. = 339.644m	T. = 91.880m
L. = 301.157m	L. = 276.157m	L. = 520.745m	L. = 183.677m
E. = 4.771m	E. = 30.810m	E. = 147.124m	E. = 1.688m
BANK = 0.021	BANK = 0.060	BANK = 0.060	BANK = 0.000
PI STA. NB8+411.767	PI STA EI+152.477	PI STA. NI+339.644	PI STA XO 1+487.027
N = 44859.7018	N = 44931.1345	N = 44878.5329	N = 44859.7018
E = 443427.1540	E = 442951.2506	E = 442893.0080	E = 443789.0399
PC N = 44859.7018	PC N = 44912.4568	PC N = 44539.5464	PC N = 44852.9574
E = 443577.9337	E = 443098.0539	E = 442861.8761	E = 443697.4078
PT N = 44878.7300	PT N = 45051.3022	PT N = 44835.6697	PT N = 44859.7018
E = 443277.5798	E = 442864.8804	E = 443219.9338	E = 443880.9198


TOWN OF BENNINGTON
66K

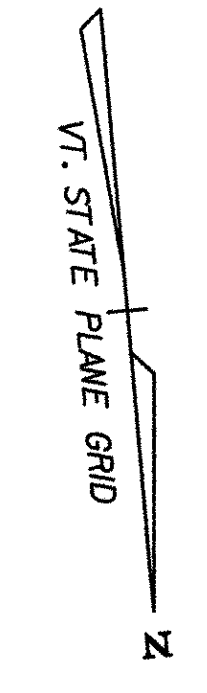

LINES SHOWN ON THIS PLAN AS EXISTING PROPERTY LINES P/L ARE BELIEVED TO BE ACCURATE BUT SHOULD NOT BE RELIED UPON FOR PURPOSES UNRELATED TO THE STATE OF VERMONT'S ACQUISITION OF LAND AND RIGHTS FOR THIS PROJECT.

THIS SHEET TO BE USED FOR RIGHT-OF-WAY INFORMATION ONLY

DATUM
VERTICAL NAVD 88
HORIZONTAL NAD 83 (1992)

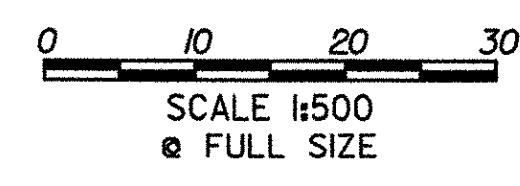

R.O.W. PLAN ROW-16	PROJECT NAME: BENNINGTON	PROJECT NUMBER: AC NH 019-(K53)
	DESIGN FILE NAME: c:\dh\bennington\row	PLOT DATE: 05-21-07
	PROJECT LEADER: JDP	DRAWN BY: MBB CHECKED BY: GAK
		SHEET: 36 OF 577