

TOWN OF BENNINGTON

66K

BENNINGTON SCHOOL DISTRICT INC.

65

CURVE CNI	
Δ	= 91°05' 41.6"
R.	= 465.700m
T.	= 474.685
L.	= 740.419m
E.	= 199.283
BANK	= 0.069
Ls	= 61.000m
θ	= 03°45' 08.9"
Ts	= 572.307m
Lt	= 40.676m
St	= 20.342m
PI STA.	CN2+187.328
N	= 45343.9089
E	= 442869.5951
TS N	= 44808.2875
E	= 442868.6700
SC N	= 44869.2261
E	= 442871.1345
CS N	= 45335.2994
E	= 442395.0283
ST N	= 45329.2762
E	= 442334.1728

CURVE FI	
Δ	= 242° 12' 47.6" RT.
R.	= 55.000m
T.	= N/A
L.	= 232.508m
E.	= N/A
BANK	= 0.060
PC N	= 44961.0456
E	= 442541.0127
PT N	= 45035.4530
E	= 442828.9462

CURVE KI	
Δ	= 79°07' 24.3" RT.
R.	= 400.000m
T.	= 330.459
L.	= 552.386m
E.	= 118.848
BANK	= 0.060
PI STA.	NI+330.459
N	= 44845.4016
E	= 442861.0274
PC N	= 44927.8249
E	= 442541.0127
PT N	= 44515.5829
E	= 442840.4696

CURVE LI	
Δ	= 274°03' 49.1" LT.
R.	= 55.000m
T.	= N/A
L.	= 263.082m
E.	= N/A
BANK	= 0.060
PC N	= 44831.1487
E	= 442860.0699
PT N	= 44888.7677
E	= 442812.0978


CURVE MI	
Δ	= 266°08' 11.5" RT.
R.	= 55.000m
T.	= N/A
L.	= 255.473m
E.	= N/A
BANK	= 0.060
PC N	= 44872.3329
E	= 442941.2524
PT N	= 44821.0215
E	= 442879.4076

CURVE NI	
Δ	= 93°41' 00.4" RT.
R.	= 318.482m
T.	= 339.644m
L.	= 520.745m
E.	= 147.124m
BANK	= 0.060
PI STA.	NI+339.644
N	= 44878.5329
E	= 442883.0050
PC N	= 44539.5464
E	= 442861.8761
PT N	= 44835.6697
E	= 443219.9338

LINES SHOWN ON THIS PLAN AS EXISTING PROPERTY LINES P/L ARE BELIEVED TO BE ACCURATE BUT SHOULD NOT BE RELIED UPON FOR PURPOSES UNRELATED TO THE STATE OF VERMONT'S ACQUISITION OF LAND AND RIGHTS FOR THIS PROJECT.

THIS SHEET TO BE USED FOR RIGHT-OF-WAY INFORMATION ONLY

DATUM	
VERTICAL	NAVD 88
HORIZONTAL	NAD 83 (1992)

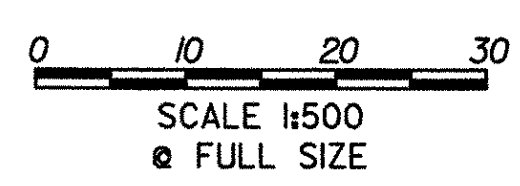

R.O.W. PLAN
ROW-17

PROJECT NAME: BENNINGTON
DESIGN FILE NAME: c:\ndh\bennington\row
PROJECT LEADER: JDP

PROJECT NUMBER: AC NH 019-1(53)

PLOT DATE: 05-21-07
DRAWN BY: MBB
CHECKED BY: GAK

SHEET: 37 OF 577

