

CURVE NB9	
Δ	= 76° 32' 26.4"
R.	= 527.595m
T.	= 416.226m
L.	= 704.807m
E.	= 144.417m
BANK	= 0.079
Ls	= 60.400m
Os	= 3° 16' 46.8"
Ts	= 498.050m
Lt	= 40.274m
St	= 20.140m
PI STA.	NB10+673.238
N	= 45043.6252
E	= 442179.2121
TS	N = 44958.7993
E	= 44958.7993
SC	N = 44967.5622
E	= 442588.4319
CS	N = 45459.3070
E	= 442157.9418
ST	N = 45519.6931
E	= 442157.1585

CURVE KI	
Δ	= 79° 07' 24.3" RT.
R.	= 400.000m
T.	= 330.459
L.	= 552.386m
E.	= 118.848
BANK	= 0.060
PI STA.	NI+330.459
N	= 44845.4016
E	= 442861.0274
PC	N = 44927.8249
E	= 442541.0127
PT	N = 44515.5828
E	= 442840.4696


CURVE CD2	
Δ	= 38° 11' 00.4"
R.	= 569.473m
T.	= 197.106m
L.	= 379.512m
E.	= 33.146m
BANK	= 0.057
PI STA.	CDI+354.159
N	= 44946.2264
E	= 442417.4518
PCC	N = 45086.6515
E	= 442279.1353
PT	N = 44921.3520
E	= 442612.9817

CURVE SB9	
Δ	= 76° 40' 45.2"
R.	= 550.702m
T.	= 435.537m
L.	= 737.007m
E.	= 151.413m
BANK	= 0.079
Ls	= 61.713m
Os	= 3° 12' 37.3"
Ts	= 519.185m
Lt	= 41.149m
St	= 20.577m
PI STA.	SB10+640.432
N	= 45023.7967
E	= 442156.5660
TS	N = 44935.7938
E	= 442645.9195
SC	N = 44944.7226
E	= 4425844.8645
CS	N = 45458.7909
E	= 442134.8315
ST	N = 45520.4904
E	= 442134.0560

DATUM
 VERTICAL NAVD 88
 HORIZONTAL NAD 83 (1992)

LINES SHOWN ON THIS PLAN AS EXISTING PROPERTY LINES P/L ARE BELIEVED TO BE ACCURATE BUT SHOULD NOT BE RELIED UPON FOR PURPOSES UNRELATED TO THE STATE OF VERMONT'S ACQUISITION OF LAND AND RIGHTS FOR THIS PROJECT.

THIS SHEET TO BE USED FOR RIGHT-OF-WAY INFORMATION ONLY

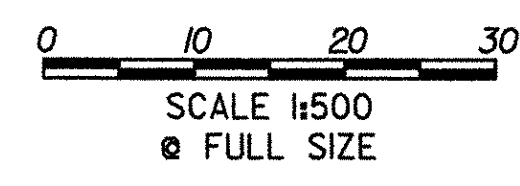

R.O.W. PLAN
ROW-18

PROJECT NAME: BENNINGTON
 DESIGN FILE NAME: c:\dh\bennington\row
 PROJECT LEADER: JDP

PROJECT NUMBER: AC NH 019-(K53)

PLOT DATE: 05-21-07
 DRAWN BY: MBB
 CHECKED BY: GAK
 SHEET: 38 OF 577