

MATCH LINE SHEET ROW-22A

MATCH LINE STA. N 1+600, ROW-17

MATCH LINE STA. N 1+200, ROW-17


CURVE NI	
Δ = 93°41'00.4" RT.	R. = 318.482m
T. = 339.644m	L. = 520.745m
E. = 147.124m	BANK = 0.060
PI STA. N1+339.644	N = 44878.5329
E = 442883.0050	PC N = 44539.5464
E = 442861.8761	PT N = 44835.6697
E = 443219.9338	

CURVE KI	
Δ = 79°07'24.3" RT.	R. = 400.000m
T. = 330.459	L. = 552.386m
E. = 118.848	BANK = 0.060
PI STA. N1+330.459	N = 44845.4016
E = 442861.0274	PC N = 44927.8249
E = 442541.0127	PT N = 44515.5828
E = 442840.4696	

DATUM	
VERTICAL	NAVD 88
HORIZONTAL	NAD 83 (1992)

LINES SHOWN ON THIS PLAN AS EXISTING PROPERTY LINES P/L ARE BELIEVED TO BE ACCURATE BUT SHOULD NOT BE RELIED UPON FOR PURPOSES UNRELATED TO THE STATE OF VERMONT'S ACQUISITION OF LAND AND RIGHTS FOR THIS PROJECT.

THIS SHEET TO BE USED FOR RIGHT-OF-WAY INFORMATION ONLY

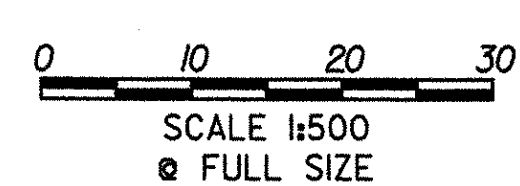

R.O.W. PLAN ROW-22	PROJECT NAME:	BENNINGTON	PROJECT NUMBER:	AC NH 019-(153)	
	DESIGN FILE NAME:	c:\dh\bennington\row		PLOT DATE:	05-21-07
	PROJECT LEADER:	JDP	DRAWN BY:	MBB	
			CHECKED BY:	GAK	
			SHEET:	40 OF 577	