
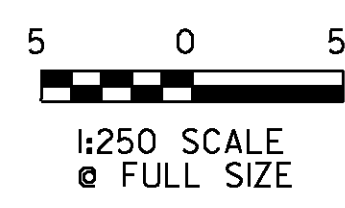


RADI TABLE				
		OFFSET	DIRECTION	RADIUS
R17	ER 1+264.820	9.5m	RT	5.0m
R18	ER 1+278.452	9.5m	RT	5.0m

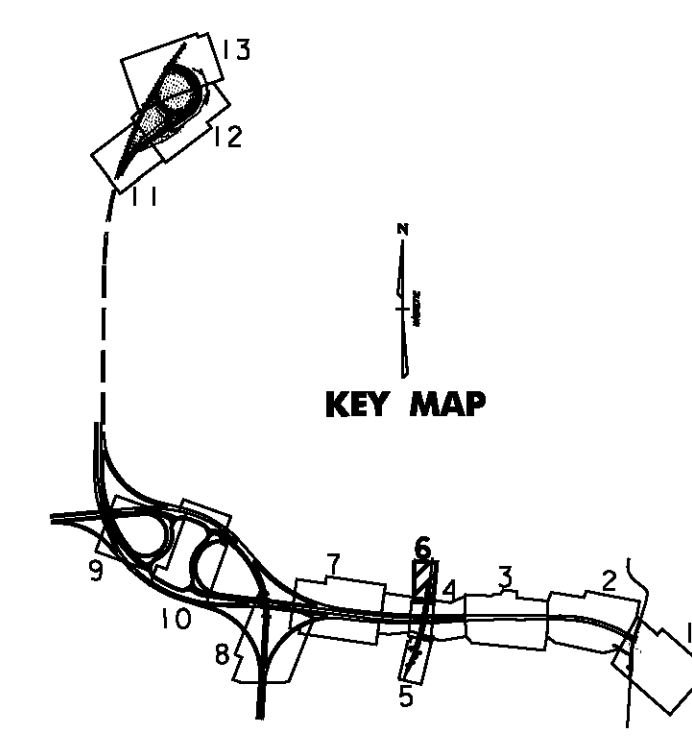

NOTE: 1) SEE SHEETS TC-02 & TC-03 ALIGNMENT DATA RELATING TO EAST ROAD DETOUR.

VERMONT AGENCY OF TRANSPORTATION			
	PROJECT NAME:	BENNINGTON	
	PROJECT NUMBER:	AC NH 019-(153)	
	FILE NAME:	... \plot_files\zd307c3alg.ptf	PLOT DATE: 5/16/2011
	DESIGN SUPERVISOR:	GREG EDWARDS	DRAWN BY: STANTEC
	DESIGNED BY:	MARC FOISY	CHECKED BY: GARY SANTY
	ALIGNMENT PLAN	A-06	SHEET 58 OF 577

V:\9513\active\95130002A\transportation\drawing\contract_3\plot_files\zd307c3alg.ptf