


**RECORD PLANS**

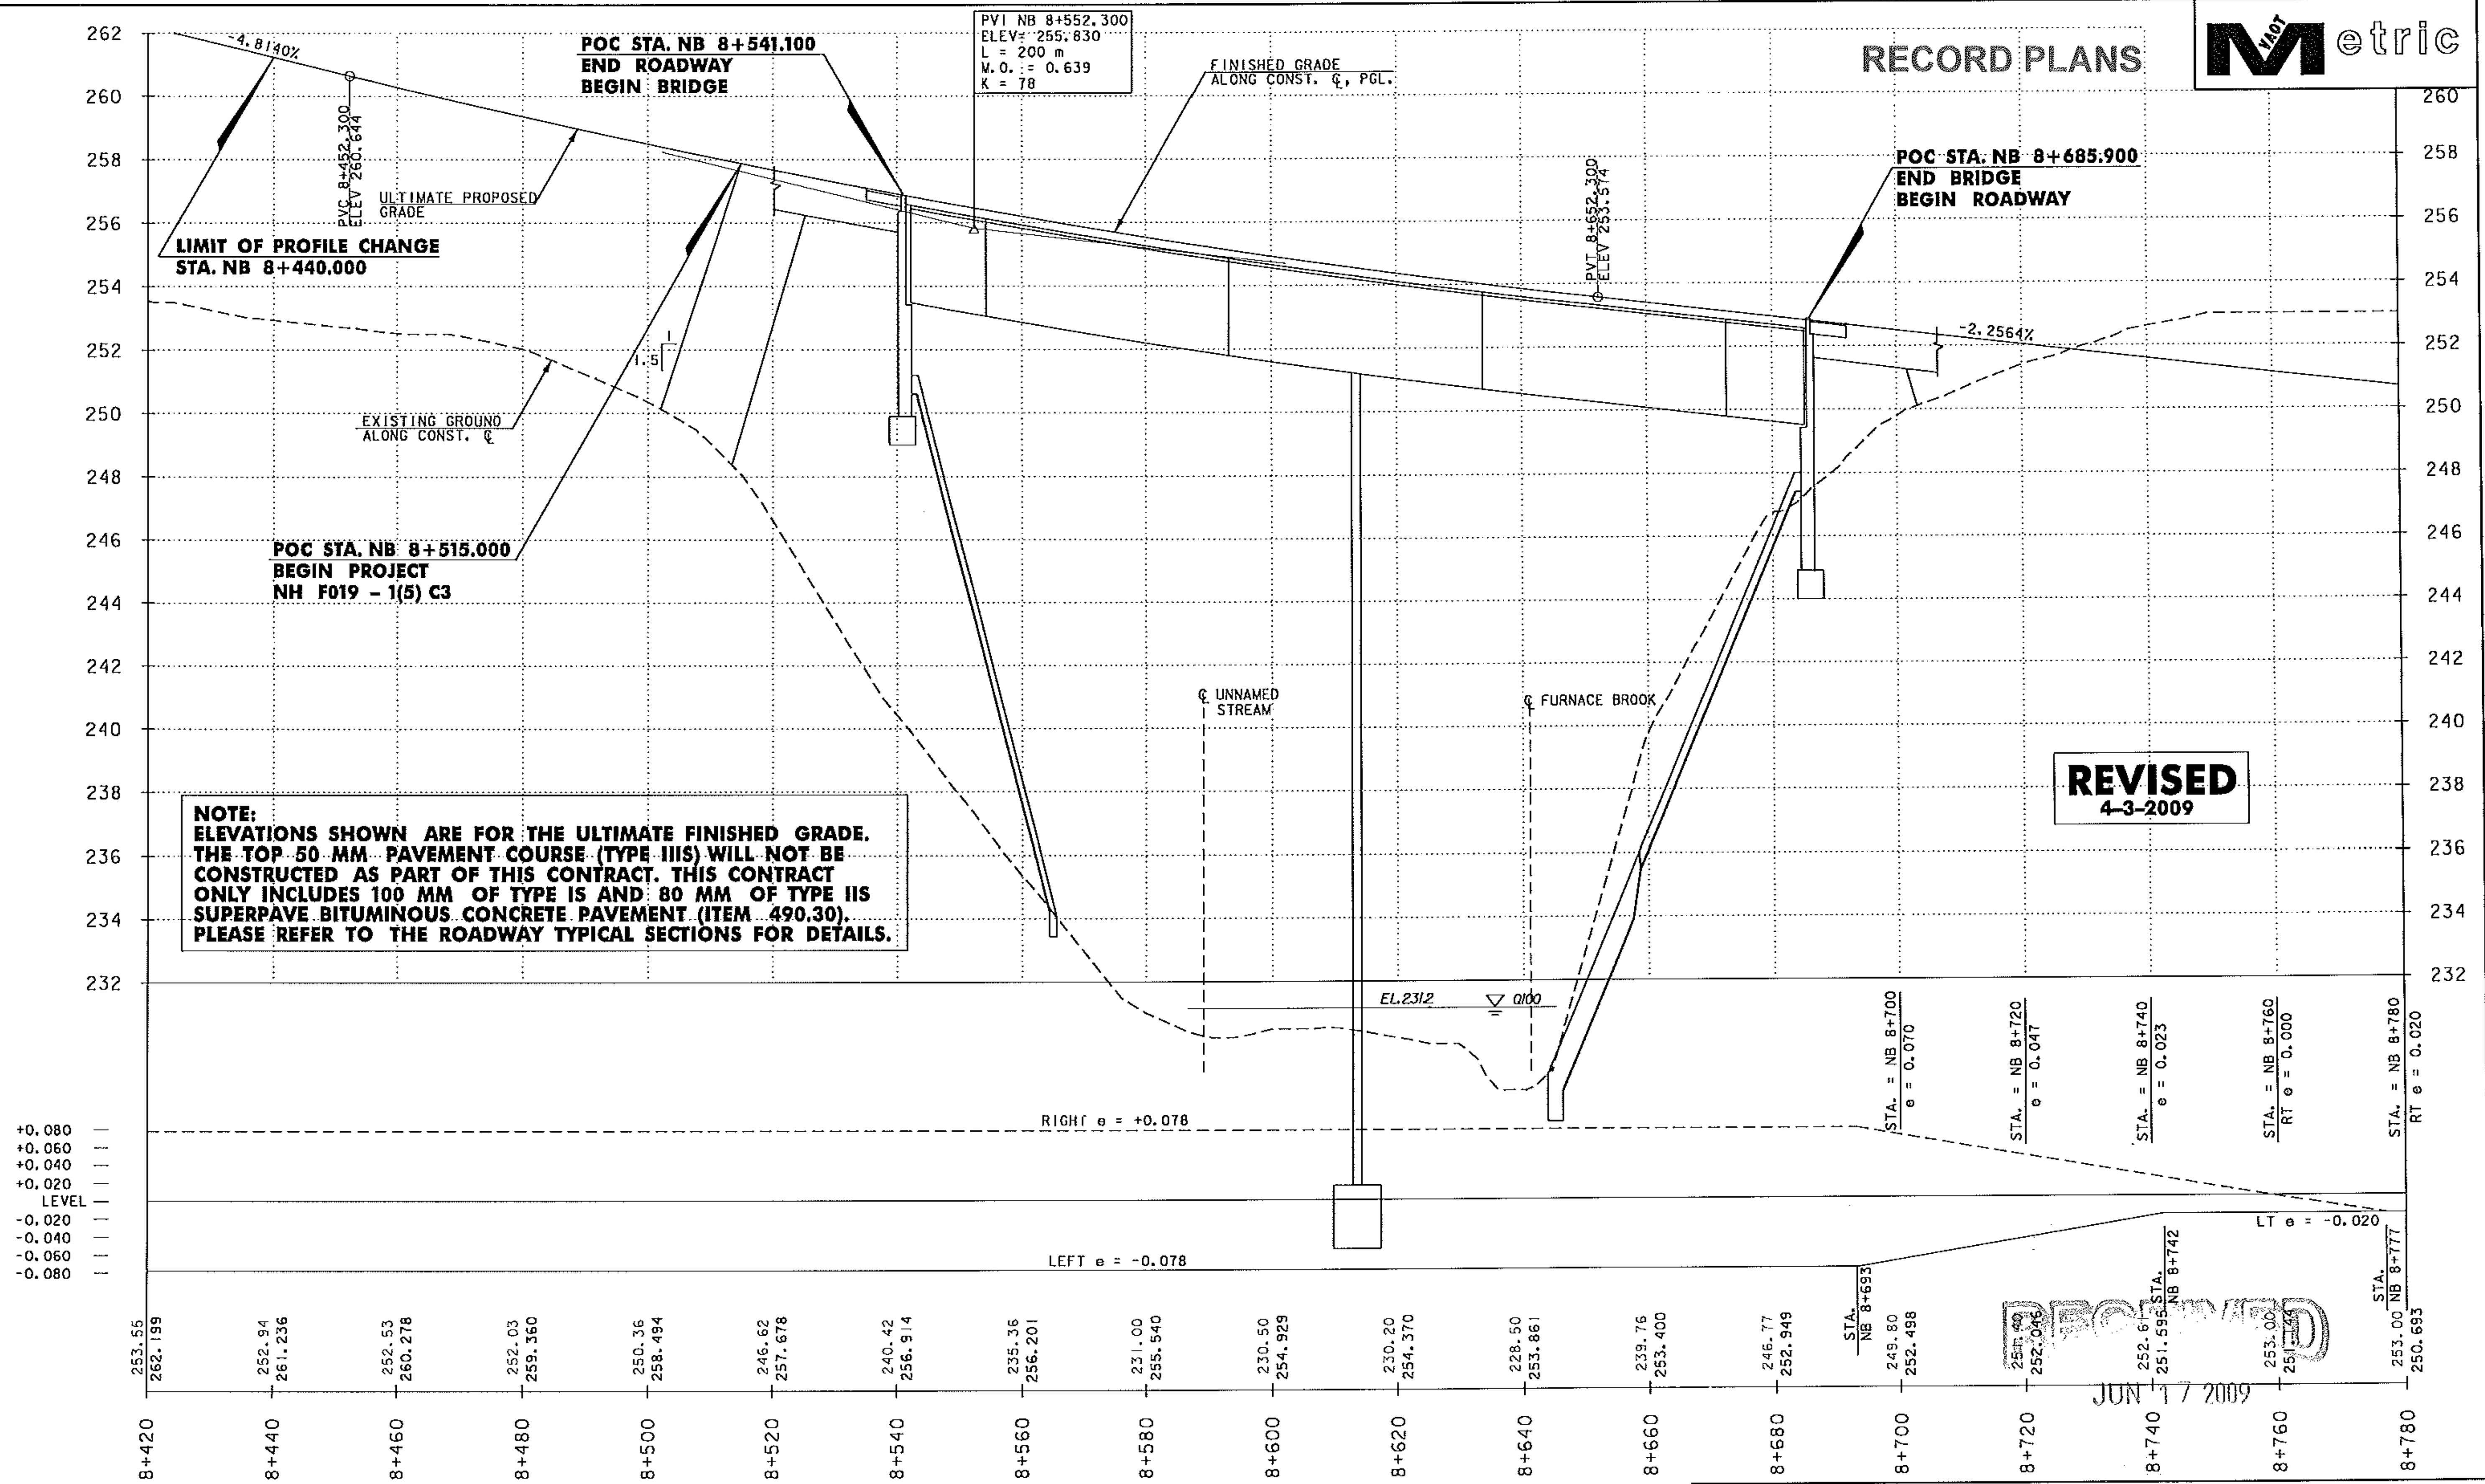


**NOTE:**  
 ELEVATIONS SHOWN ARE FOR THE ULTIMATE FINISHED GRADE.  
 THE TOP 50-MM PAVEMENT COURSE (TYPE IIIIS) WILL NOT BE  
 CONSTRUCTED AS PART OF THIS CONTRACT. THIS CONTRACT  
 ONLY INCLUDES 100 MM OF TYPE IS AND 80 MM OF TYPE IIS  
 SUPERPAVE BITUMINOUS CONCRETE PAVEMENT (ITEM 490.30).  
 PLEASE REFER TO THE ROADWAY TYPICAL SECTIONS FOR DETAILS.

**VERMONT AGENCY OF TRANSPORTATION**

PROJECT NAME: BENNINGTON  
 PROJECT NUMBER: AC NH 019-1(53)

FILE NAME: ...z307c3revised.pro.nb.ptf PLOT DATE: 6/16/2009  
 DESIGN SUPERVISOR: GREG EDWARDS DRAWN BY: STANTEC  
 DESIGNED BY: MARC FOISY CHECKED BY: GARY SANTY  
 NORTHBOUND - PR-1 SHEET 66 OF 577

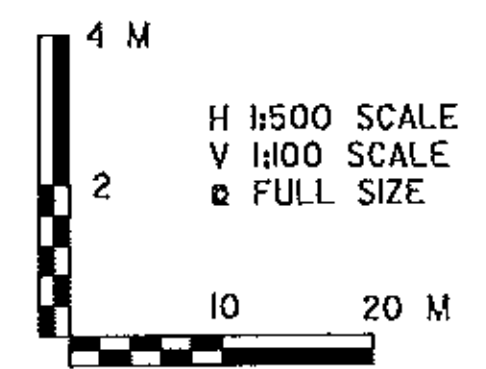

v:\1983\vertical\9530002\tr\map\revisions\drawing\contract\3\vertical\revisions\z307c3revised.pro.nb.ptf