

SUPERSEDED
 BY
 PRECEDING
 SHEET


+0.080
 +0.060
 +0.040
 +0.020
 LEVEL
 -0.020
 -0.040
 -0.060
 -0.080

VERMONT AGENCY OF TRANSPORTATION



PROJECT NAME: BENNINGTON
 PROJECT NUMBER: AC NH 019-I(53)

FILE NAME: ...plot_files\zd307c3pro_nb.prf PLOT DATE: 5/18/2007
 DESIGN SUPERVISOR: GREG EDWARDS DRAWN BY: STANTEC
 DESIGNED BY: MARC FOISY CHECKED BY: GARY SANTY
 NORTHBOUND - PR-2 SHEET 67 OF 577

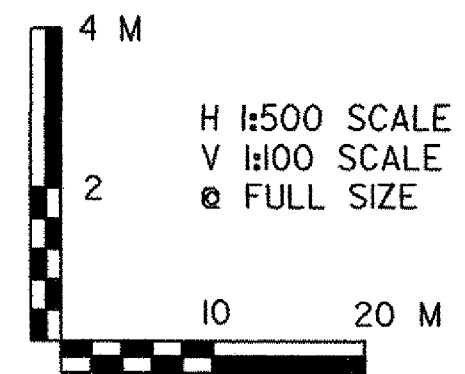

V:\953\active\9530002\transportation\drawing\contract\3\plot_files\zd307c3pro_nb.prf