


NOTE:
 ELEVATIONS SHOWN ARE FOR THE ULTIMATE FINISHED GRADE.
 THE TOP 50 MM PAVEMENT COURSE (TYPE IIIS) WILL NOT BE
 CONSTRUCTED AS PART OF THIS CONTRACT. THIS CONTRACT
 ONLY INCLUDES 100 MM OF TYPE IIS AND 80 MM OF TYPE IIS
 SUPERPAVE BITUMINOUS CONCRETE PAVEMENT (ITEM 490.30).
 PLEASE REFER TO THE ROADWAY TYPICAL SECTIONS FOR DETAILS.



VERMONT AGENCY OF TRANSPORTATION

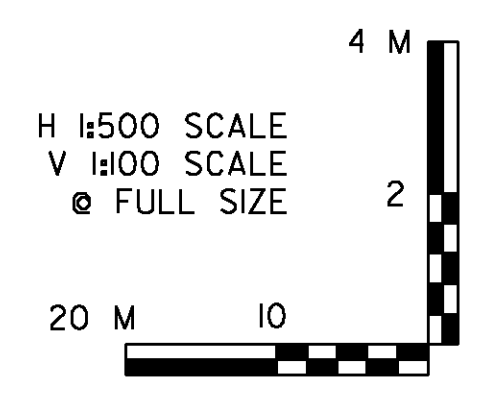

PROJECT NAME:	BENNINGTON
PROJECT NUMBER:	AC NH 019-(53)
FILE NAME:	...plot_files\zd307c3pro_xo.ptf
DESIGN SUPERVISOR:	GREG EDWARDS
DESIGNED BY:	MARC FOISY
CROSSOVER PR-5	
PLOT DATE:	5/26/2011
DRAWN BY:	STANTEC
CHECKED BY:	GARY SANTY
SHEET	70 OF 577

V:\1953\active\1953\0002\1r\enb\p\10\10\drawing\centr\act_3\plot_files\zd307c3pro_xo.ptf