


SUPERSEDED  
BY  
PRECEDING  
SHEET

**NOTE:**  
ELEVATIONS SHOWN ARE FOR THE ULTIMATE FINISHED GRADE. THE TOP 50 MM PAVEMENT COURSE (TYPE IIIS) WILL NOT BE CONSTRUCTED AS PART OF THIS CONTRACT. THIS CONTRACT ONLY INCLUDES 100 MM OF TYPE IS AND 80 MM OF TYPE IIS SUPERPAVE BITUMINOUS CONCRETE PAVEMENT (ITEM 490.30). PLEASE REFER TO THE ROADWAY TYPICAL SECTIONS FOR DETAILS.

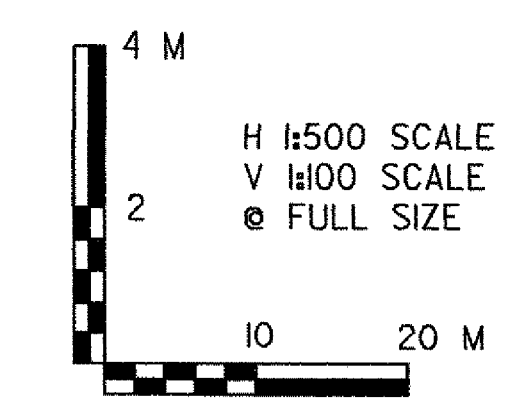

**VERMONT AGENCY OF TRANSPORTATION**

PROJECT NAME: BENNINGTON  
PROJECT NUMBER: AC NH 019-1(53)

FILE NAME: ...plot\_files\zd307c3pro\_xo.ptf PLOT DATE: 5/18/2007  
DESIGN SUPERVISOR: GREG EDWARDS DRAWN BY: STANTEC  
DESIGNED BY: MARC FOISY CHECKED BY: GARY SANTY  
**CROSS OVER PR-7** SHEET 72 OF 577

V:\953\active\9530002\transportation\drawing\contract\_3\plot\_files\zd307c3pro\_xo.ptf