


- NOTES:
1. FOR PROJECT TERMINI DETAIL, SEE SHEET TS-08.
  2. FOR SUBBASE TRANSITION DETAIL, AT BRIDGE ABUTMENT AND UNDERNEATH APPROACH SLAB, SEE SHEET TS-08.

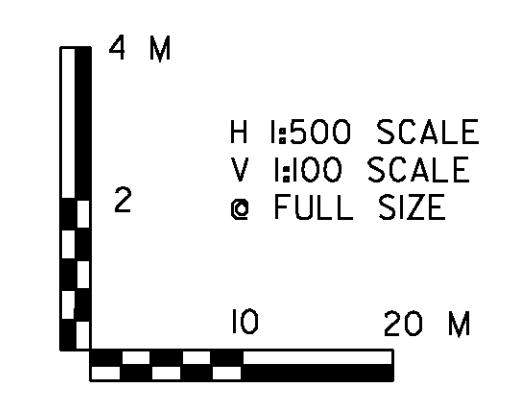

**VERMONT AGENCY OF TRANSPORTATION**

PROJECT NAME: BENNINGTON	DRAWN BY: STANTEC
PROJECT NUMBER: AC NH 019-(153)	CHECKED BY: GARY SANTY
FILE NAME: ...\\plot_files\zd307c3pro_east.ptf	PLOT DATE: 5/16/2011
DESIGN SUPERVISOR: GREG EDWARDS	
DESIGNED BY: MARC FOISY	
<b>EAST ROAD - PR-8</b>	

v:\9531\active\95310002\transportation\drawing\contract\_3\plot\_files\zd307c3pro\_east.ptf