


- NOTES:
- FOR PROJECT TERMINI DETAIL, SEE SHEET TS-08.
 - FOR MORE INFORMATION ON THE BRIDGE APPROACH SLAB SEE BRIDGE PLANS.
 - FOR SUBBASE TRANSITION DETAIL, AT BRIDGE ABUTMENT AND UNDERNEATH APPROACH SLAB, SEE SHEET TS-08.



VERMONT AGENCY OF TRANSPORTATION

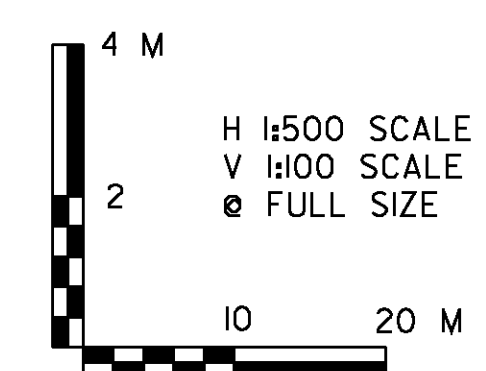

PROJECT NAME: BENNINGTON
 PROJECT NUMBER: AC NH 019-(153)
 FILE NAME: ...\\plot_files\zd307c3pro_east.ptf PLOT DATE: 5/16/2011
 DESIGN SUPERVISOR: GREG EDWARDS DRAWN BY: STANTEC
 DESIGNED BY: MARC FOISY CHECKED BY: GARY SANTY
EAST ROAD - PR-9 SHEET 74 OF 577

V:\953\002\1\transportation\drawing\contract_3\plot_files\zd307c3pro_east.ptf