


v:\953\active\9530002\transportation\drawing\contract_3\plot_files\zd307c3pro_si_fill.plt

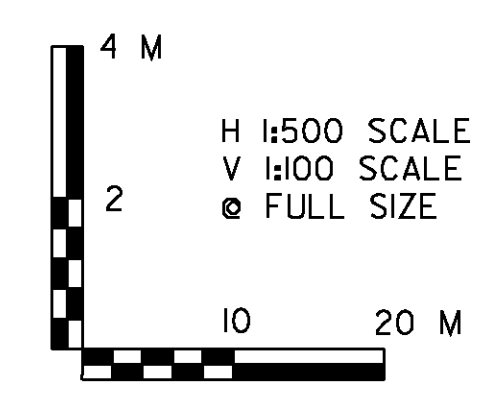

VERMONT AGENCY OF TRANSPORTATION	
	PROJECT NAME: BENNINGTON
	PROJECT NUMBER: AC NH 019-(153)
	FILE NAME: ...\\zd307c3pro_si_fill.plt
	PLOT DATE: 5/16/2011
DESIGN SUPERVISOR: GREG EDWARDS	DRAWN BY: STANTEC
DESIGNED BY: MARC FOISY	CHECKED BY: GARY SANTY
WC WASTE SITE PR-12	SHEET 77 OF 577