

NOTES:

- EAST ROAD DETAILED ON SHEETS P-05 TO P-07.
- FOR PROJECT DEMARCATION FENCE AROUND THE WASTE/BORROW/STAGING AREA, SEE EROSION CONTROL SHEET EC-05.
- FOR EAST ROAD GUARDRAIL LOCATIONS, SEE SHEET P-06.

WOVEN WIRE FENCE WITH STEEL POSTS

STA. NB 9+140.0 - NB 9+265.5, RT.
 STA. NB 9+265.5 - NB 9+500.0, RT.
 STA. XO 1+035.0 - XO 1+217.6, RT.
 STA. XO 1+252.0 - XO 1+400.0, RT.

PROJECT DEMARCATION FENCE

STA. NB 9+140.0 - NB 9+265.7, RT.
 STA. XO 1+040.0 - XO 1+178.5, RT.
 STA. XO 1+252.0 - XO 1+400.0, RT.

THREE BEAM GUARDRAIL

STA. NB 9+255.0, LT. TO 9+311.0, LT.
 (FOR DETAILS SEE SHEET MD-1)

CONSTRUCT U-TURN

STA. NB 9+320.0, LT.
 FOR DETAILS, SEE VTrans STD. B-17

CLAY BORROW

STA. XO 1+179.0 - 1+220.0, RT.



SLEEVES FOR UTILITIES, 200



STA. NB 9+397.9 LT-RT

BARRIER FENCE

STA. XO 1+179.5 - XO 1+210.8, RT

REMOVAL OF EXISTING FENCE

STA. NB 9+140.0 - NB 9+215.9, LT.
 STA. NB 9+140.0 - NB 9+265.1, RT.
 STA. NB 9+205.7 - NB 9+215.9, 71.5m, LT.
 STA. NB 9+205.7 - NB 9+275.4, LT.
 STA. NB 9+275.4 - NB 9+265.1, 41.9m, RT.
 STA. NB 9+499.2 - NB 9+500.0, LT.
 STA. NB 9+499.2 - NB 9+500.0, 36.8m, LT.

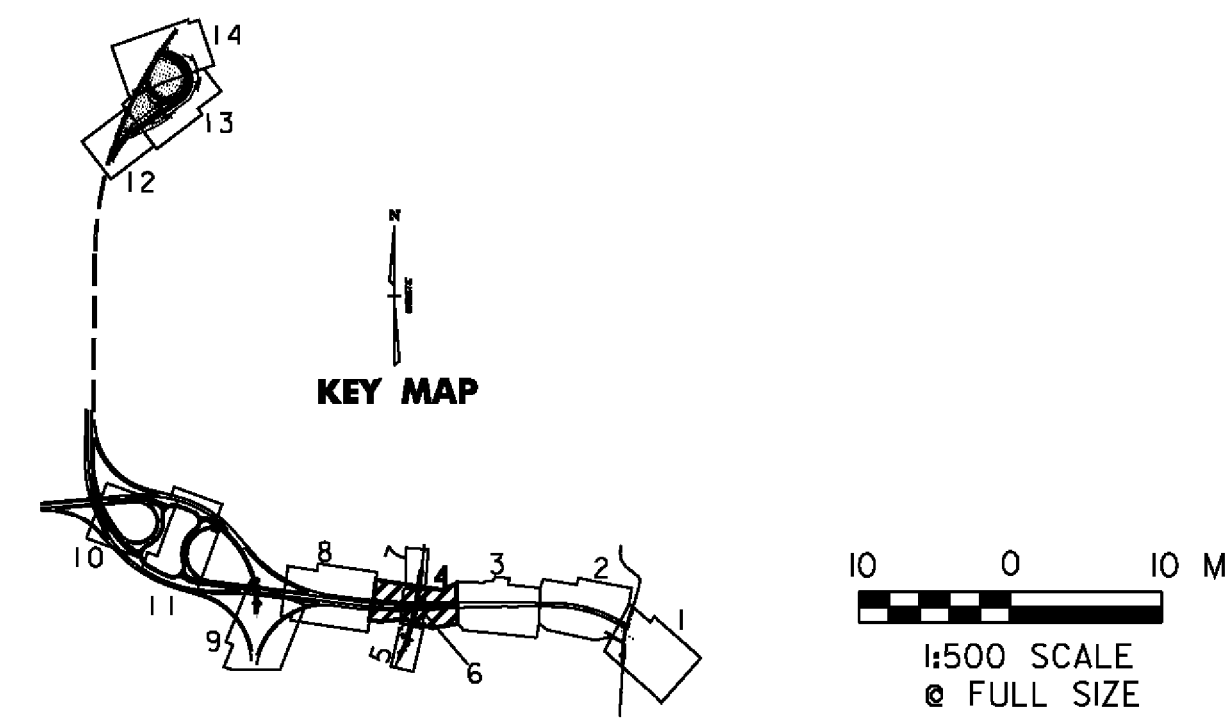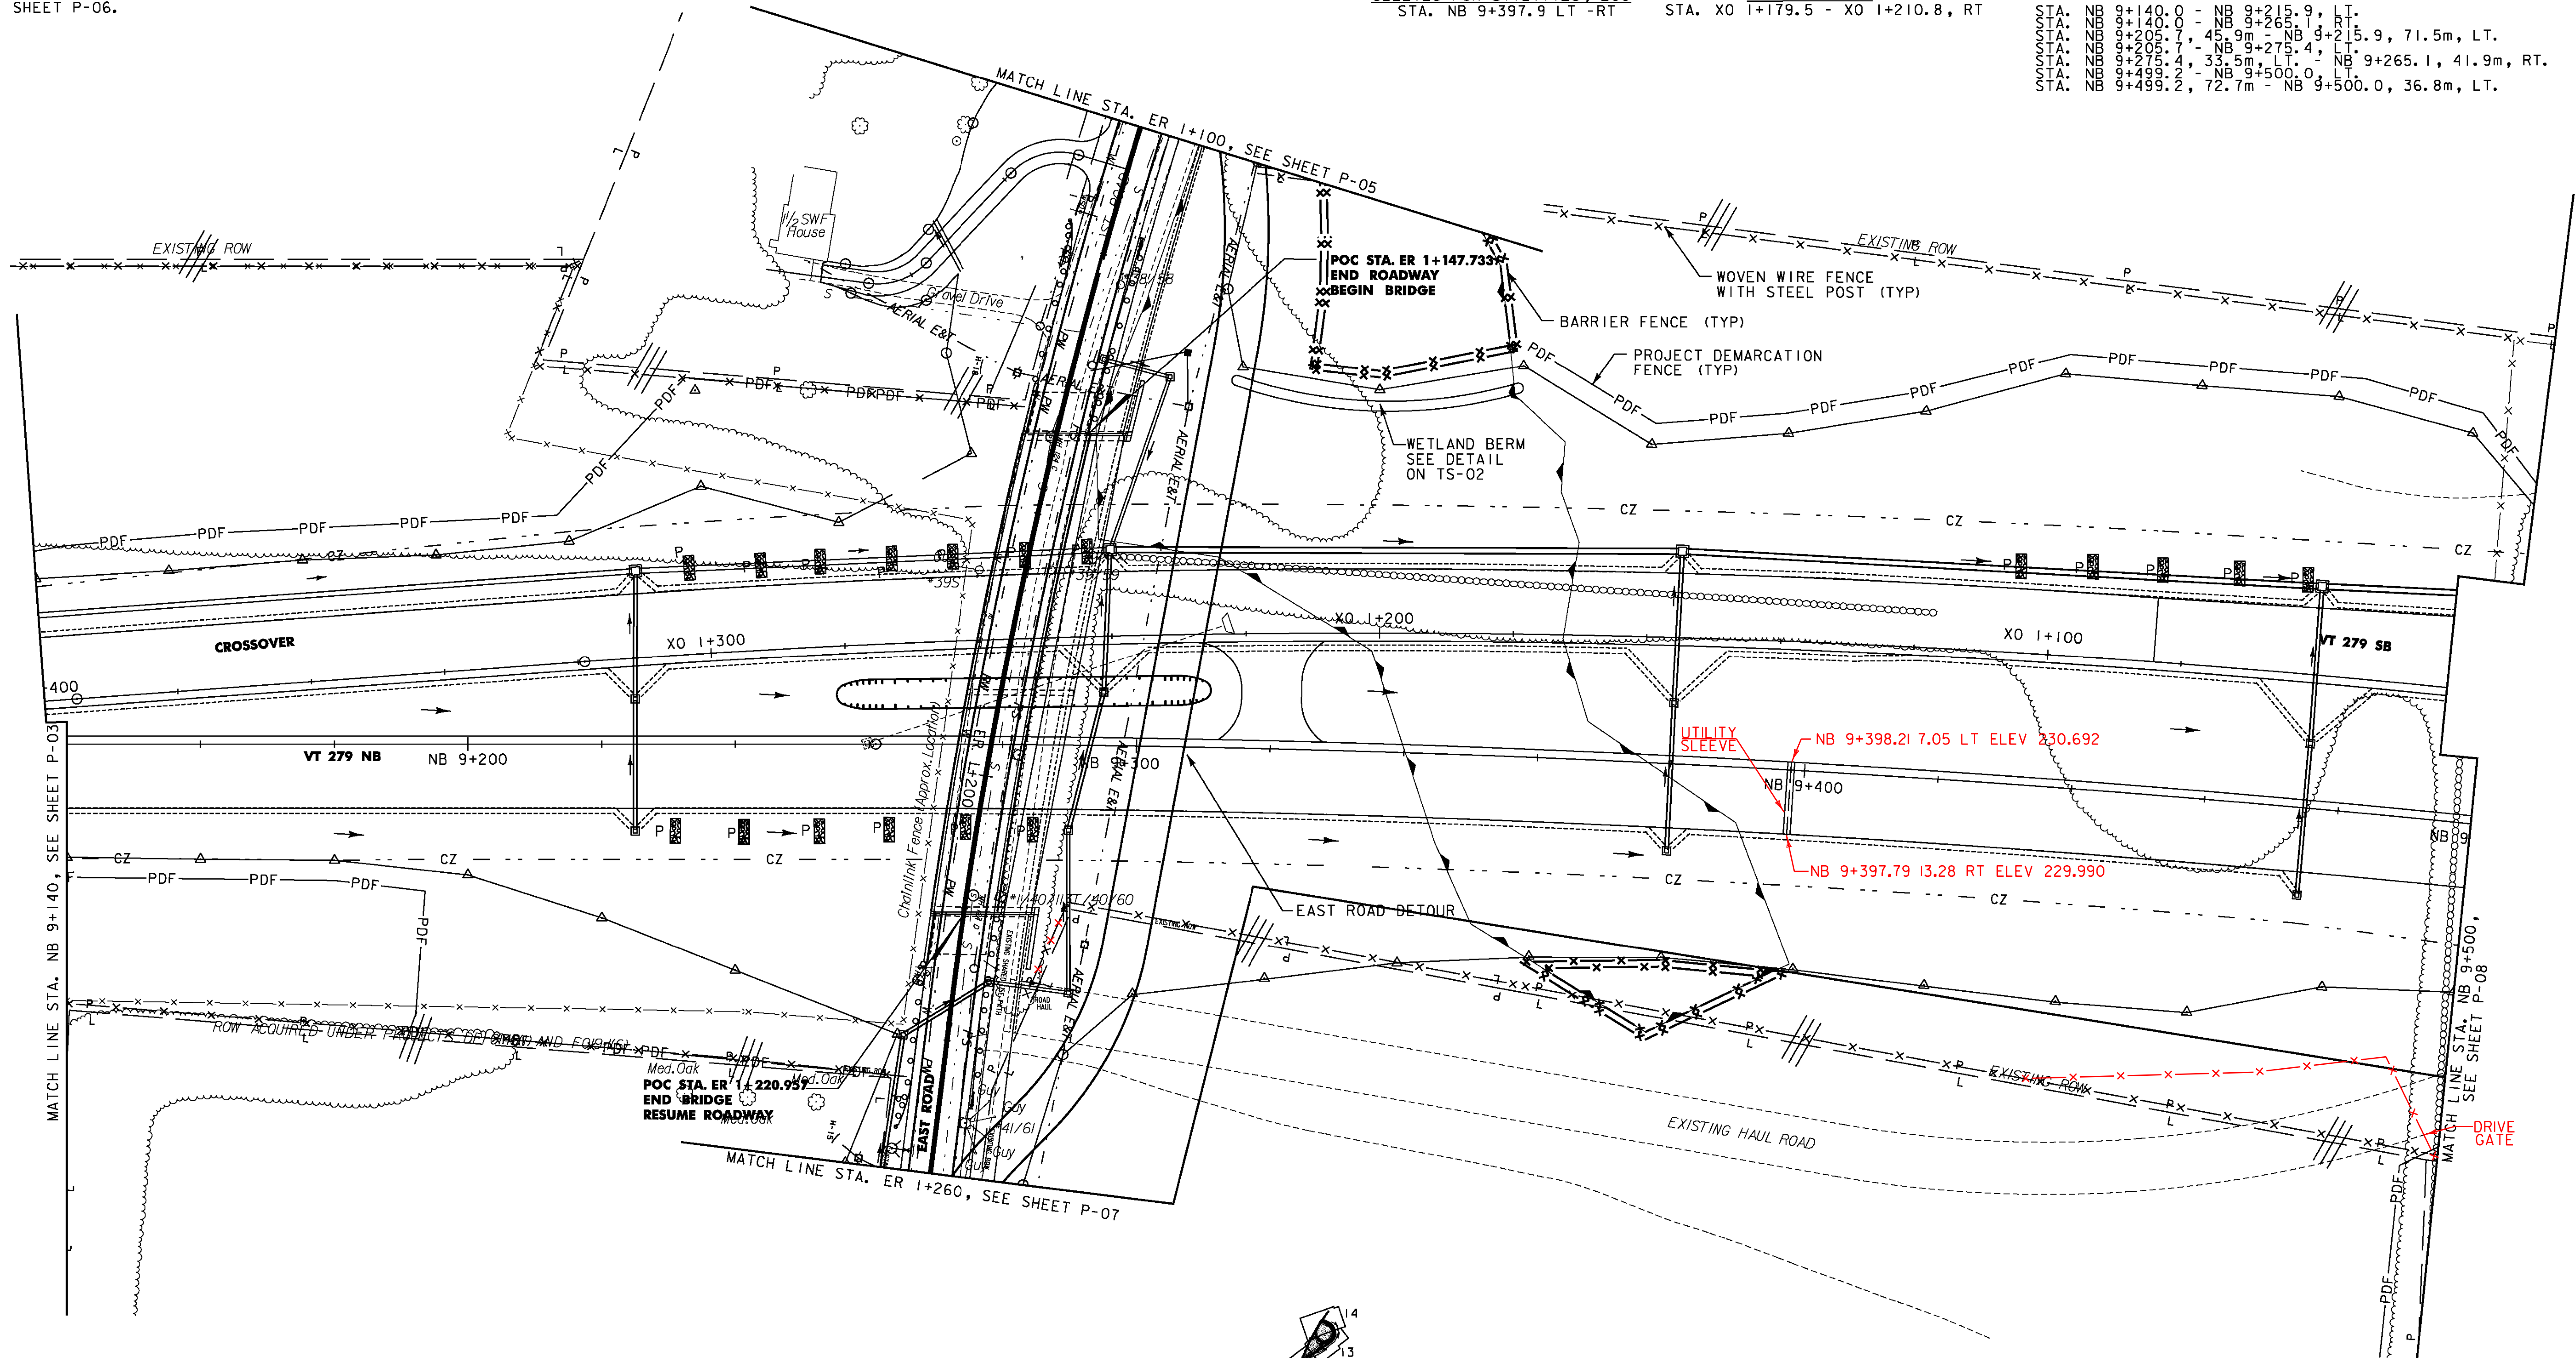

VERMONT AGENCY OF TRANSPORTATION



PROJECT NAME:	BENNINGTON
PROJECT NUMBER:	AC NH 019-(153)
FILE NAME:	...z307c3gen.plans.ptf
DESIGN SUPERVISOR:	GREG EDWARDS
DESIGNED BY:	MARC FOISY
GENERAL PLAN	P-04
PLOT DATE:	5/16/2011
DRAWN BY:	STANTEC
CHECKED BY:	GARY SANTY
SHEET	81 OF 577

V:\1953\active\1953\0002\transportation\drawing\contract\3\p101_files\z307c3gen.plans.ptf