



**PIPE NO. 451 - PIPE NO. 450  
NB 8+545 - NB 8+607**

**DP-01**

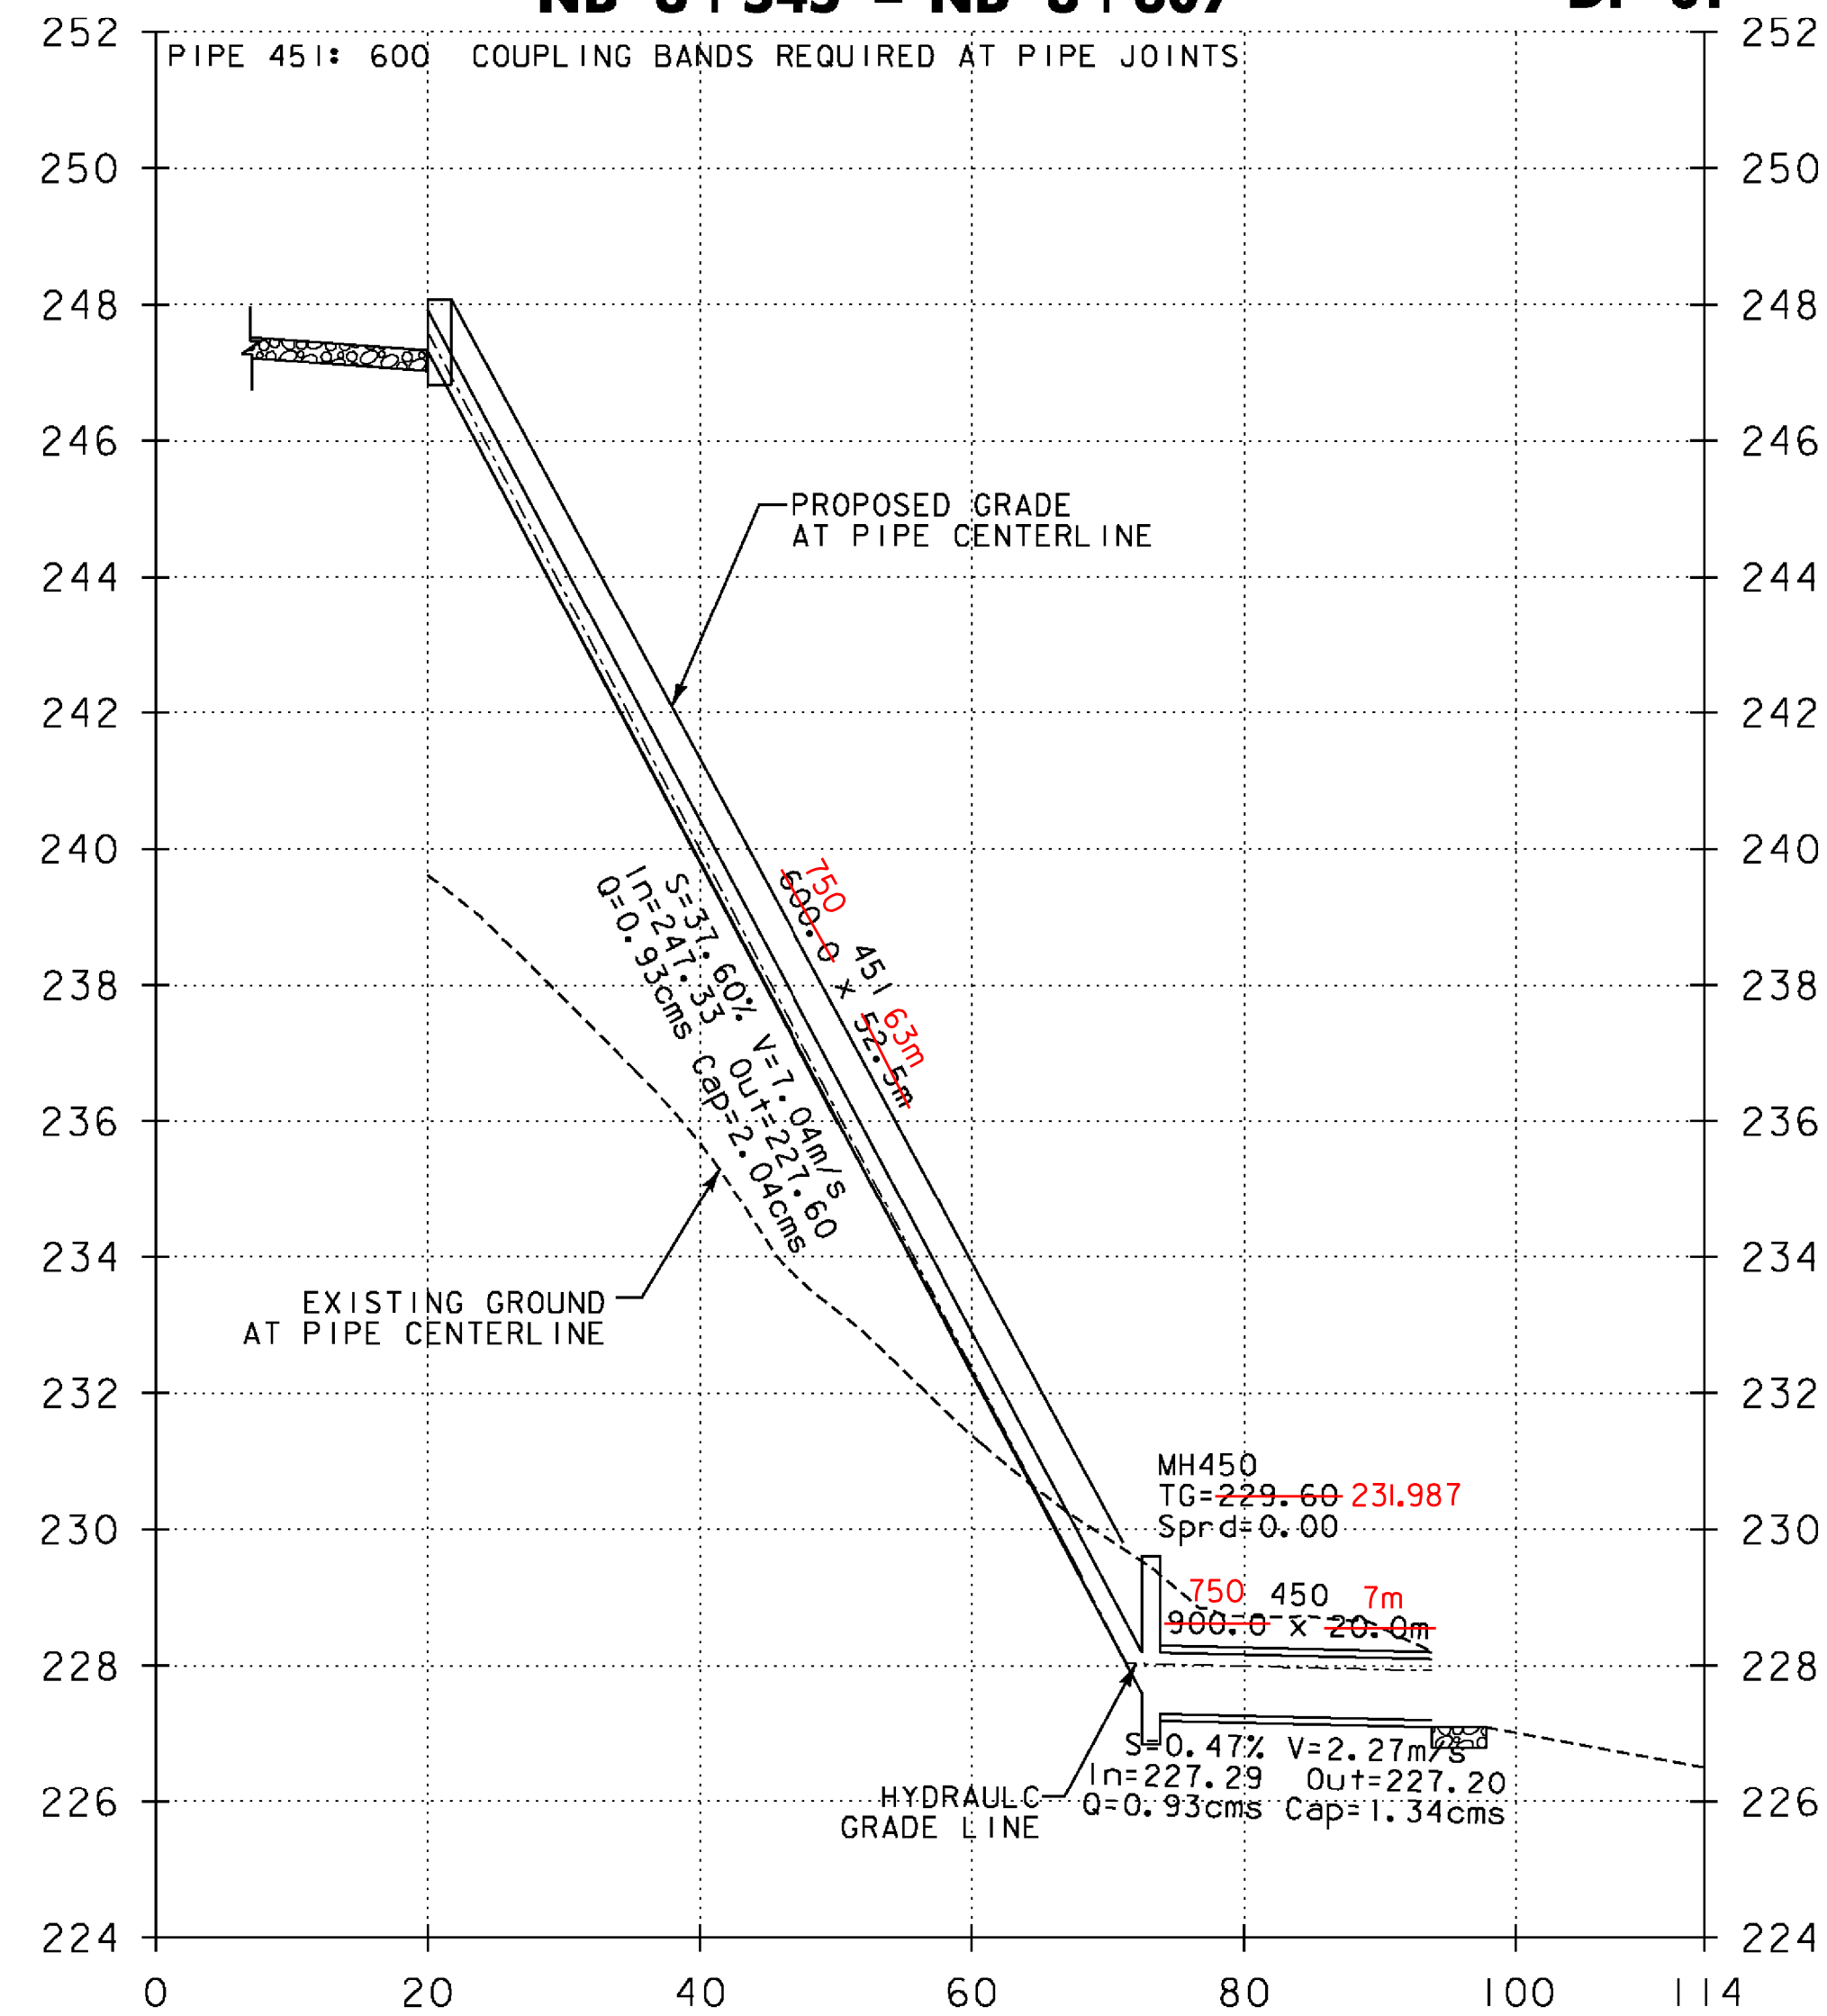

NOTE: ALL DIMENSIONS ARE IN MILLIMETERS (mm) EXCEPT WHERE NOTED.

|   |   |
|---|---|
| <b>SYSTEM 4</b>                         |   |
| <b>VERMONT AGENCY OF TRANSPORTATION</b> |   |
|   | PROJECT NAME: BENNINGTON<br>PROJECT NUMBER: AC NH 019-1(53)   |
|   | FILE NAME: ...\plot_files\zd307c3drn_pro.pptf PLOT DATE: 5/16/2011<br>DESIGN SUPERVISOR: GREG EDWARDS DRAWN BY: STANTEC<br>DESIGNED BY: MARC FOISY CHECKED BY: GARY SANTY<br><b>DRAINAGE PROFILE SHEET 1</b> SHEET 103 OF 577 |

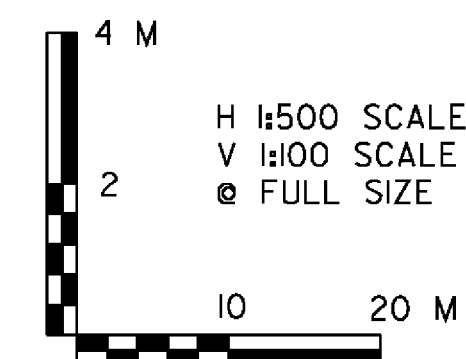

v:\1953\active\19530002\transportation\drawing\contract\_3\plot\_files\zd307c3drn\_pro.pptf