
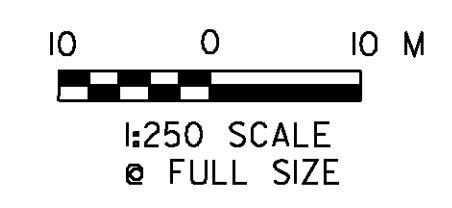



**SWALE SECTION A-A**

SCALE : H = 1:250  
V = 1:250

- NOTES:
1. SEE DRAINAGE PLANS, DP-08 FOR PIPE NOTES AND ADDITIONAL CONSTRUCTION DETAILS
  2. CONSTRUCT DRAINAGE SWALE TO BE PAID FOR AS COMMON EXCAVATION. SEE DRAINAGE DETAIL SHEET 3

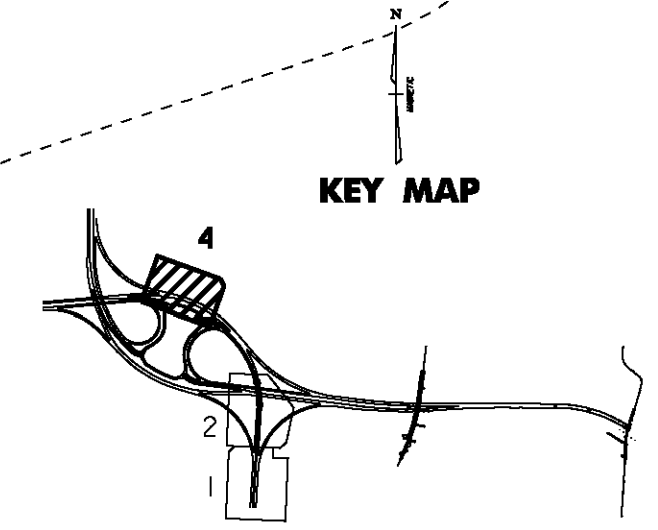

<b>VERMONT AGENCY OF TRANSPORTATION</b>	
 <p><b>Stantec</b></p>	PROJECT NAME: BENNINGTON
	PROJECT NUMBER: AC NH 019-(53)
	FILE NAME: ...\\plot_files\zd307c3swm_3.ppf
	PLOT DATE: 5/16/2011
DESIGN SUPERVISOR: GREG EDWARDS	DRAWN BY: STANTEC
DESIGNED BY: MARC FOISY	CHECKED BY: GARY SANTY
<b>SWALE GRADING PLAN SWM-4</b>	SHEET 116 OF 577