
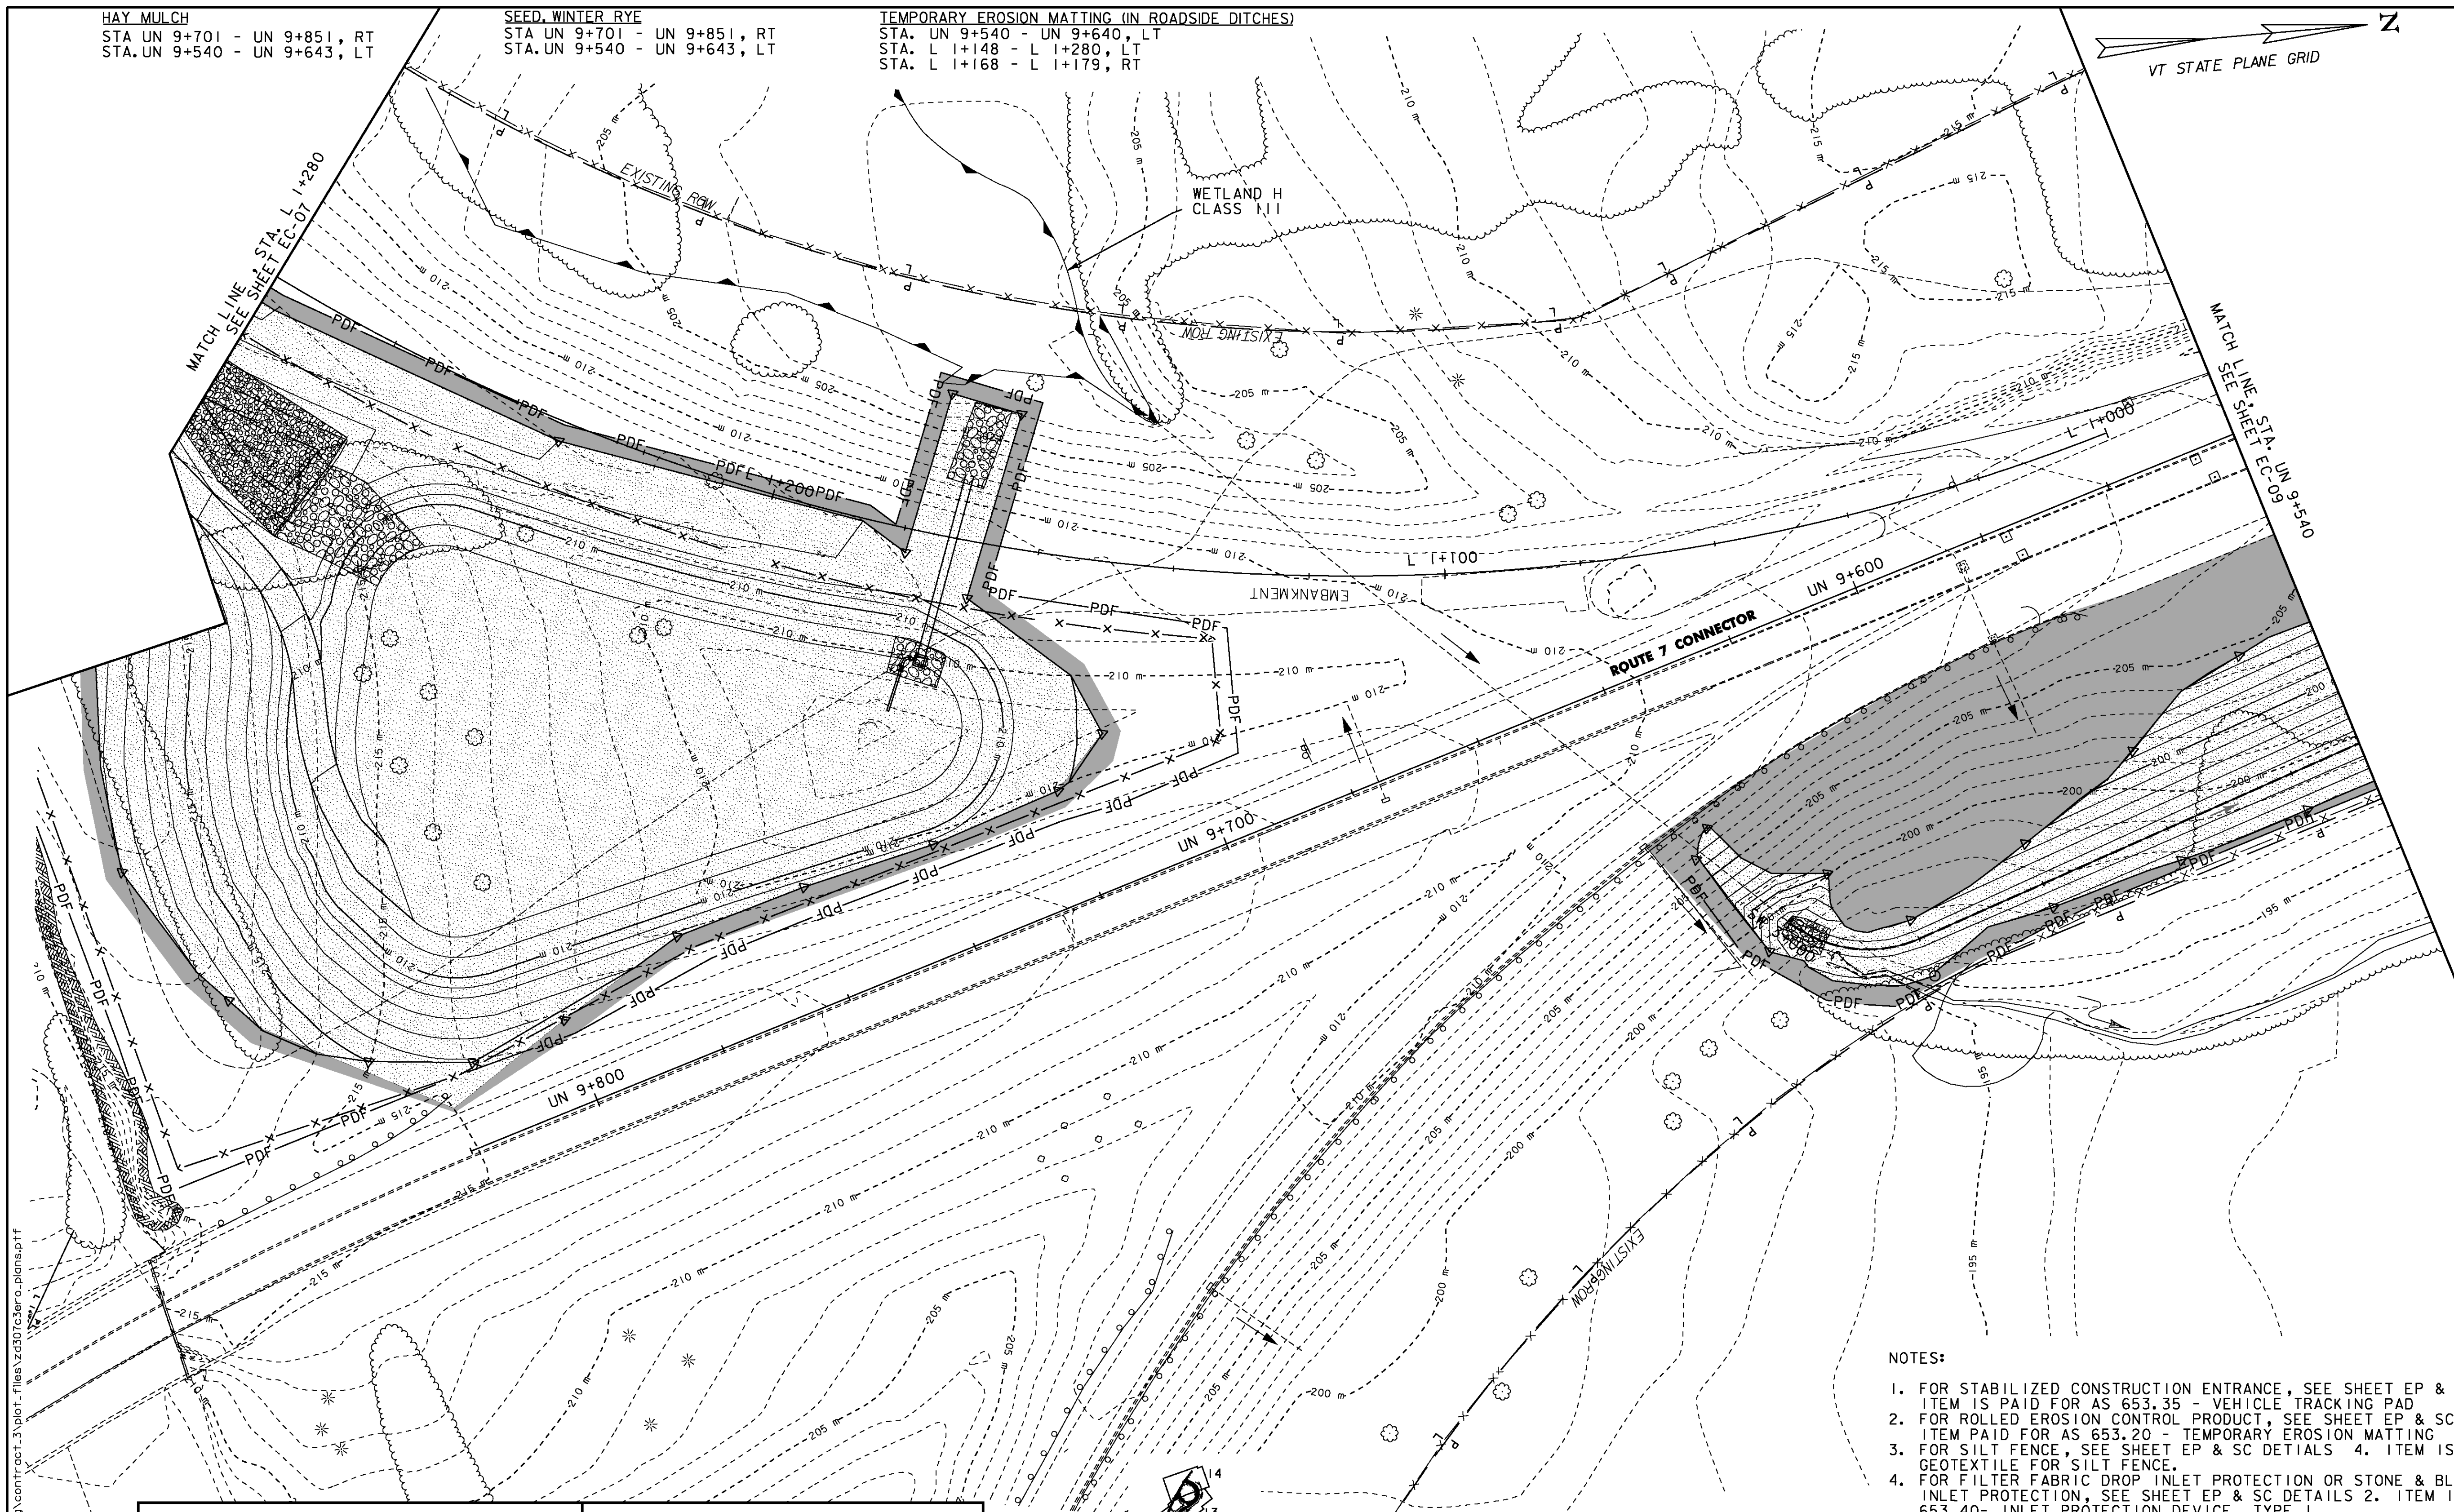


HAY MULCH
 STA UN 9+701 - UN 9+851, RT
 STA UN 9+540 - UN 9+643, LT

SEED, WINTER RYE
 STA UN 9+701 - UN 9+851, RT
 STA UN 9+540 - UN 9+643, LT



TEMPORARY EROSION MATTING (IN ROADSIDE DITCHES)
 STA UN 9+540 - UN 9+640, LT
 STA L 1+148 - L 1+280, LT
 STA L 1+168 - L 1+179, RT

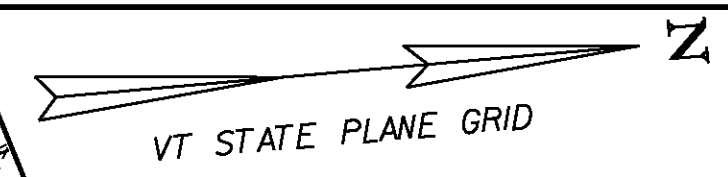

NOTES:

1. FOR STABILIZED CONSTRUCTION ENTRANCE, SEE SHEET EP & SC DETAILS 6. ITEM IS PAID FOR AS 653.35 - VEHICLE TRACKING PAD
2. FOR ROLLED EROSION CONTROL PRODUCT, SEE SHEET EP & SC DETAILS 5. ITEM PAID FOR AS 653.20 - TEMPORARY EROSION MATTING
3. FOR SILT FENCE, SEE SHEET EP & SC DETAILS 4. ITEM IS PAID FOR AS 649.51- GEOTEXTILE FOR SILT FENCE.
4. FOR FILTER FABRIC DROP INLET PROTECTION OR STONE & BLOCK DROP INLET PROTECTION, SEE SHEET EP & SC DETAILS 2. ITEM IS PAID FOR AS 653.40- INLET PROTECTION DEVICE, TYPE 1.
5. FOR CHECK DAM, SEE SHEET EP & SC DETAILS 3. ITEM IS PAID FOR AS 653.25- TEMPORARY STONE CHECK DAM, TYPE 1
6. THE STONE OUTLET PROTECTION ON THIS SHEET, WILL BE PAID UNDER ITEM 613.10 - STONE FILL, TYPE 1

LEGEND	
	VEHICLE TRACKING PAD
	TEMPORARY EROSION MATTING
	SEED AND MULCH
	SILT FENCE
	INLET PROTECTION DEVICE, TYPE I (CATCH BASIN OR DROP INLET)
	INLET PROTECTION DEVICE, TYPE I (CULVERT)
	FILTER BAG
	PERMANENT STONE CHECK DAM
	TEMPORARY STONE CHECK DAM
	STONE OUTLET PROTECTION

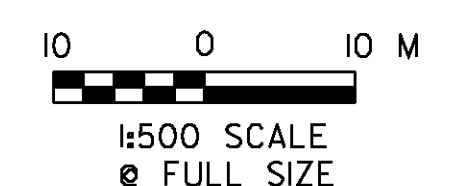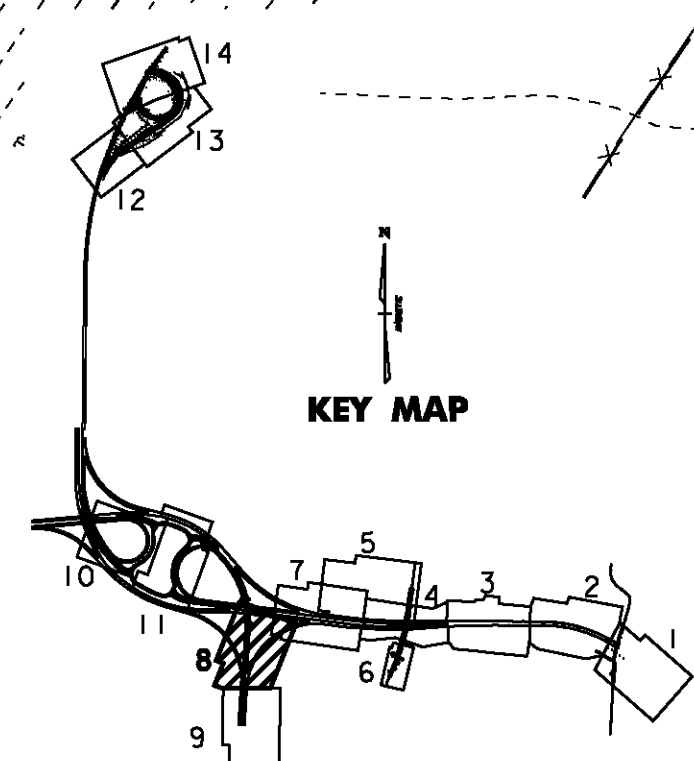

VERMONT AGENCY OF TRANSPORTATION	
	PROJECT NAME: BENNINGTON
	PROJECT NUMBER: AC NH 019-(153)
FILE NAME: ...\\zd307c3ero_plans.prf	PLOT DATE: 5/16/2011
DESIGN SUPERVISOR: GREG EDWARDS	DRAWN BY: STANTEC
DESIGNED BY: MARC FOISY	CHECKED BY: GARY SANTY
EROSION CONTROL PLAN EC-08	SHEET 127 OF 577

V:\9513\061\ve\95130002\transportation\drawing\contract\3\plot_files\zd307c3ero_plans.prf