

**TEMPORARY EROSION MATTING (ON SLOPES)**  
 STA G 1+295 - G 1+749 RT  
 STA G 1+370 - G 1+661 LT



**INLET PROTECTION DEVICE, TYPE I (CATCH BASIN)**  
 STA G 1+610, 4.5 m RT  
 STA G 1+610, 9.3 m LT  
 STA G 1+610, 46.2 m LT

**TEMPORARY STONE CHECK DAMS**  
 STA G 1+347, 5.0 m RT - STA G 1+400, 5.0 m RT  
 STA G 1+423, 9.3 m LT - STA G 1+624, 9.3 m LT  
 STA G 1+440, 4.5 m RT - STA G 1+646, 4.5 m RT

**GEOTEXTILE FOR SILT FENCE**  
 STA. G 1+339, RT II M

**SEED, WINTER RYE**  
 STA G 1+295 - G 1+336, LT  
 STA G 1+442 - G 1+660, LT  
 STA GG 1+000 - GG 1+132, LT  
 STA GG 1+123 - GG 1+132, RT


**HAY MULCH**  
 STA G 1+295 - G 1+336, LT  
 STA G 1+442 - G 1+660, LT  
 STA GG 1+000 - GG 1+132, LT  
 STA GG 1+123 - GG 1+132, RT

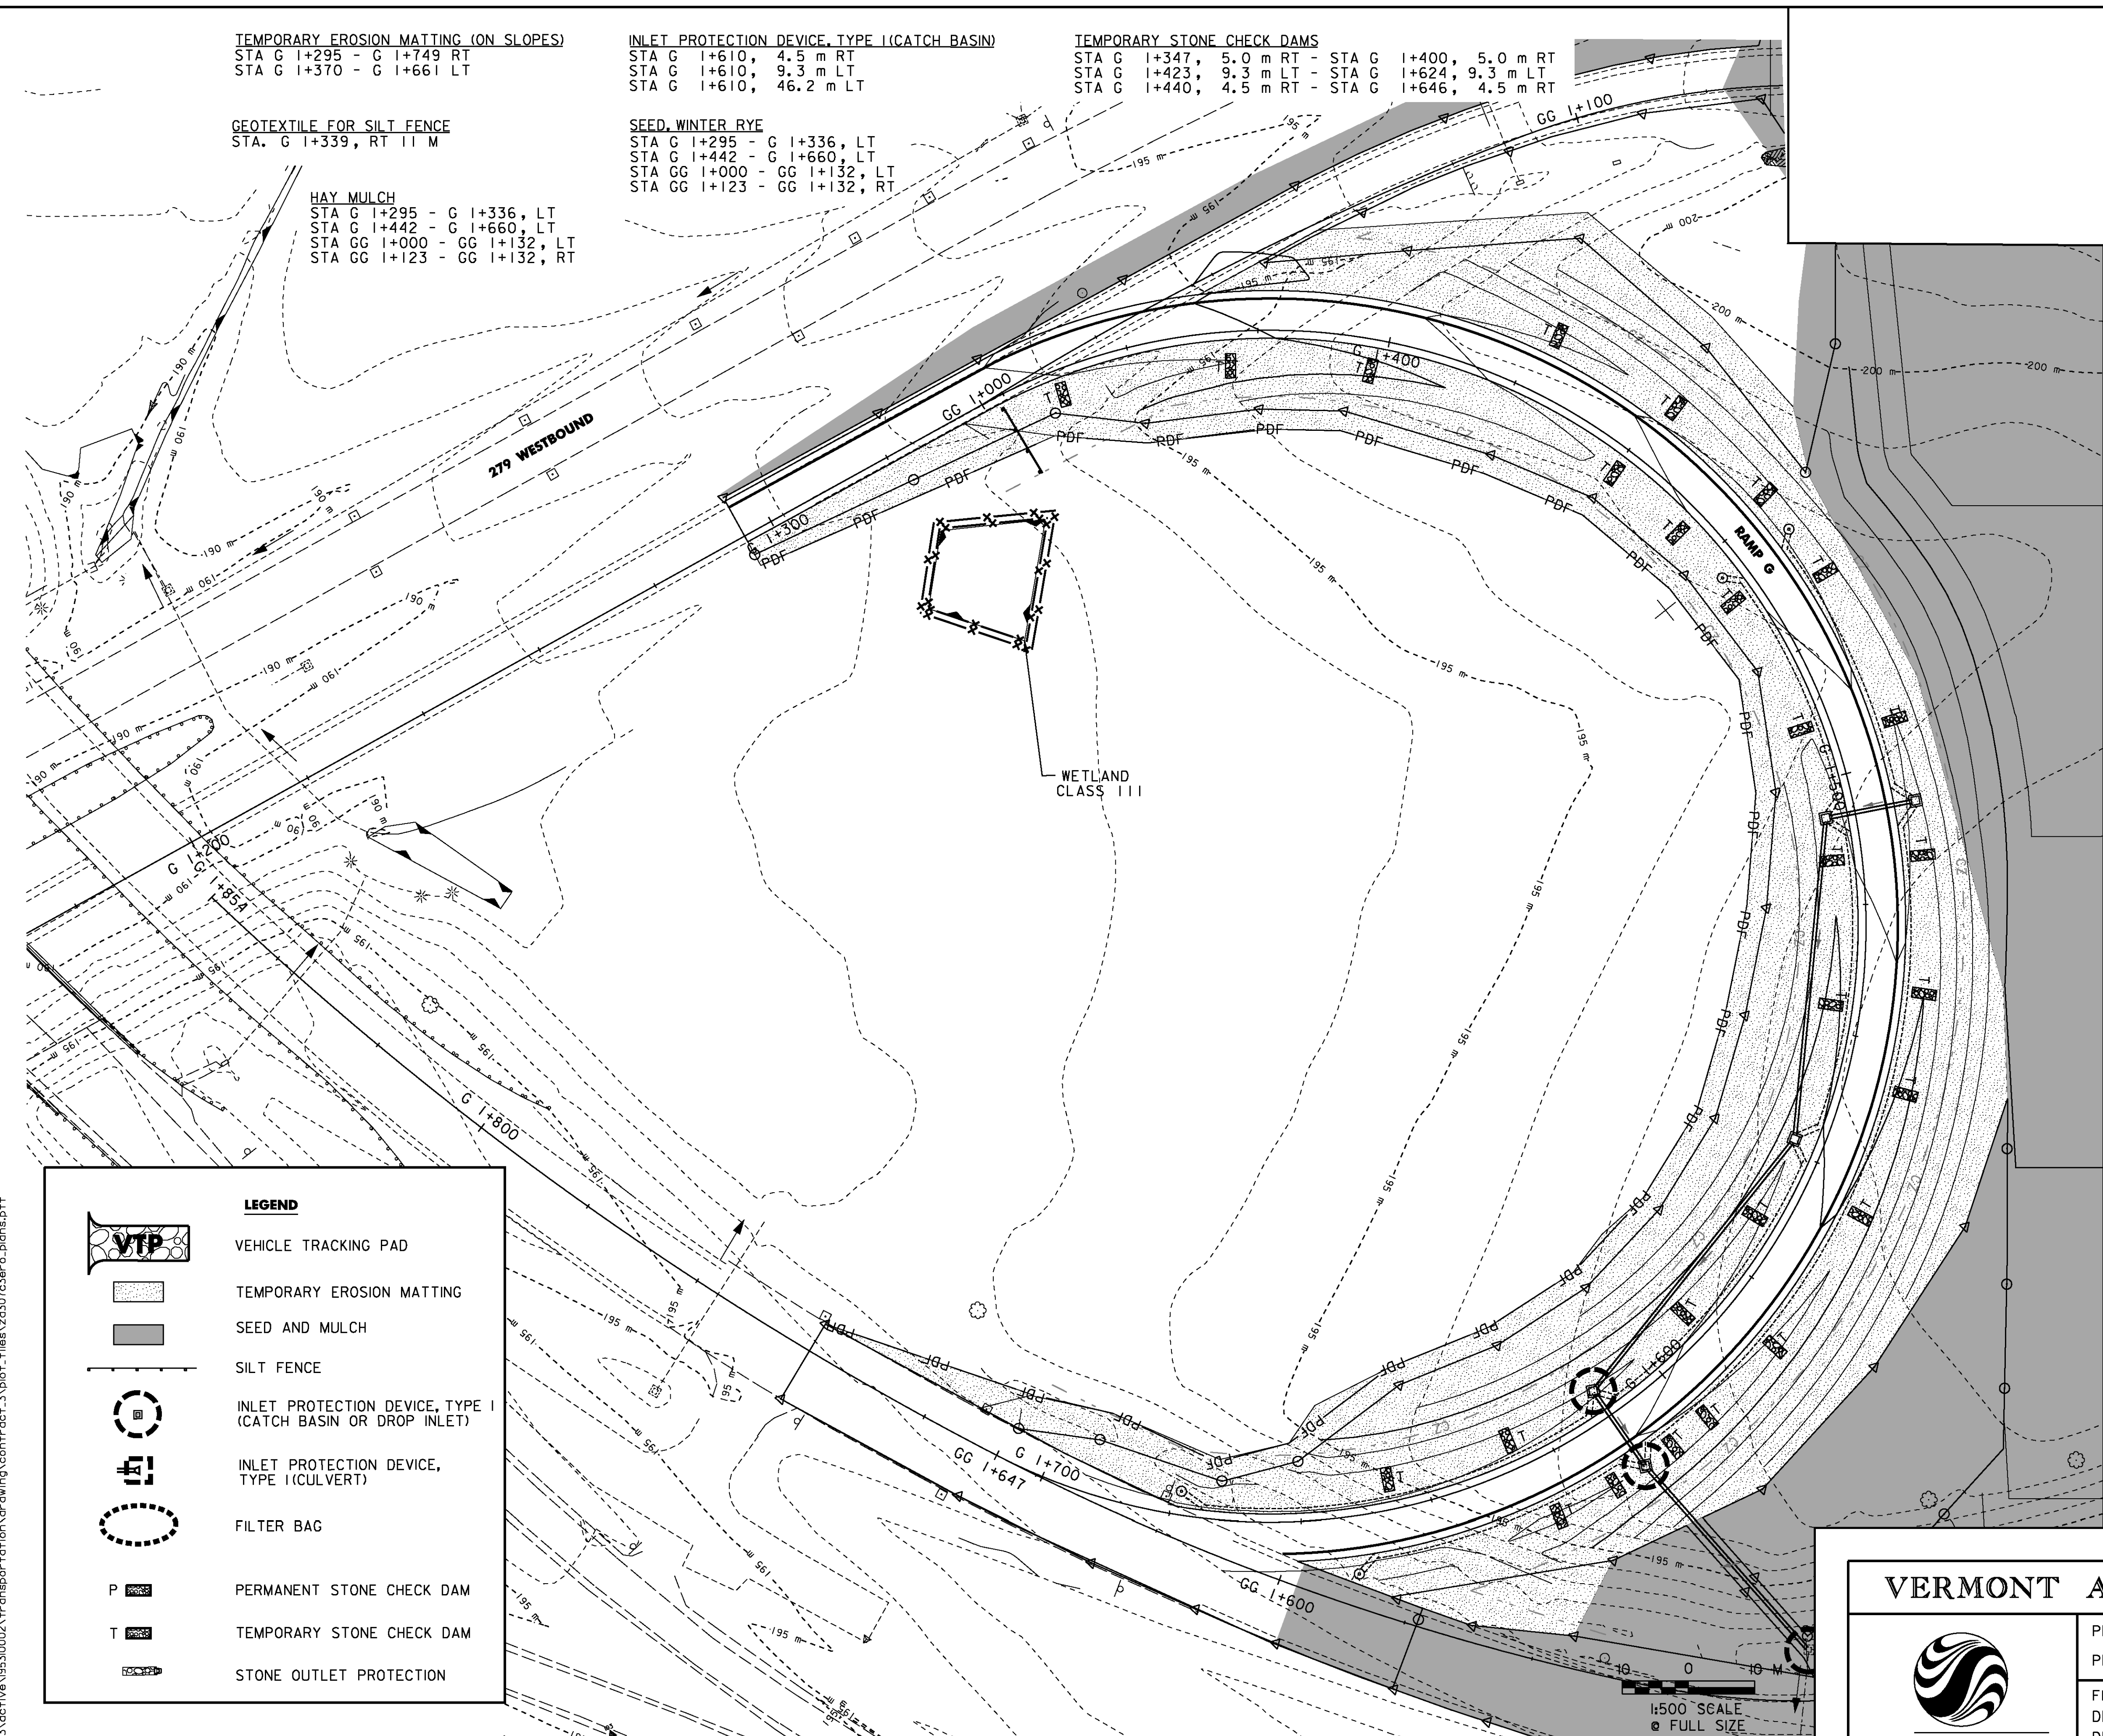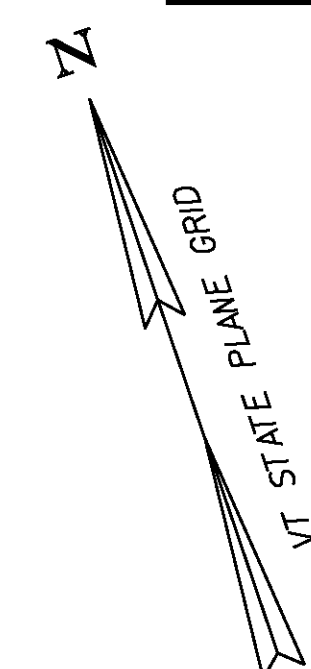

**NOTES:**

1. FOR STABILIZED CONSTRUCTION ENTRANCE, SEE SHEET EP & SC DETAILS 6. ITEM IS PAID FOR AS 653.35 - VEHICLE TRACKING PAD
2. FOR ROLLED EROSION CONTROL PRODUCT, SEE SHEET EP & SC DETAILS 5. ITEM PAID FOR AS 653.20 - TEMPORARY EROSION MATTING
3. FOR SILT FENCE, SEE SHEET EP & SC DETAILS 4. ITEM IS PAID FOR AS 649.51 - GEOTEXTILE FOR SILT FENCE.
4. FOR FILTER FABRIC DROP INLET PROTECTION OR STONE & BLOCK DROP INLET PROTECTION, SEE SHEET EP & SC DETAILS 2. ITEM IS PAID FOR AS 653.40 - INLET PROTECTION DEVICE, TYPE 1.
5. FOR CHECK DAM, SEE SHEET EP & SC DETAILS 3. ITEM IS PAID FOR AS 653.25 - TEMPORARY STONE CHECK DAM, TYPE 1

MATCH LINE  
SEE SHEET EC-11

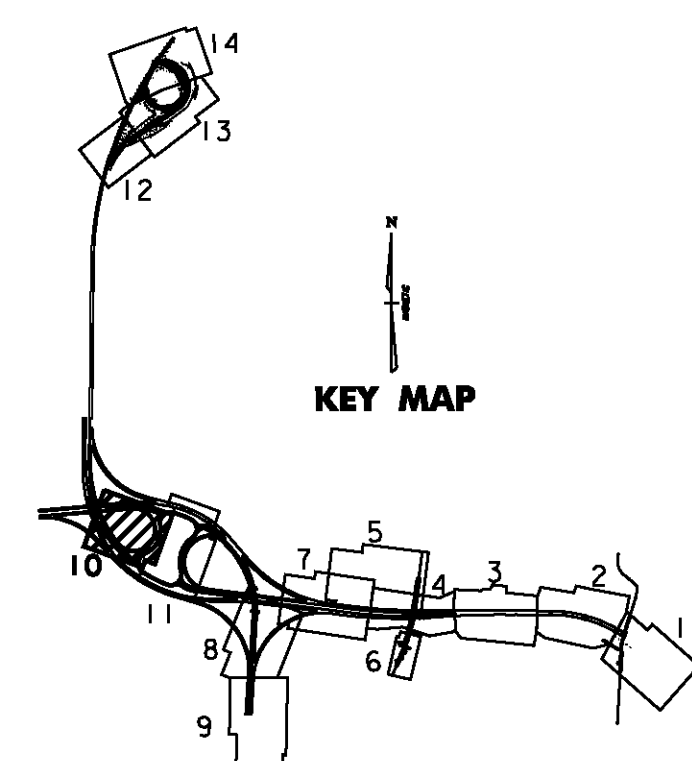

LEGEND	
	VEHICLE TRACKING PAD
	TEMPORARY EROSION MATTING
	SEED AND MULCH
	SILT FENCE
	INLET PROTECTION DEVICE, TYPE I (CATCH BASIN OR DROP INLET)
	INLET PROTECTION DEVICE, TYPE I (CULVERT)
	FILTER BAG
	PERMANENT STONE CHECK DAM
	TEMPORARY STONE CHECK DAM
	STONE OUTLET PROTECTION

1:500 SCALE  
 FULL SIZE

**VERMONT AGENCY OF TRANSPORTATION**



PROJECT NAME: BENNINGTON	PLOT DATE: 5/16/2011
PROJECT NUMBER: AC NH 019-(153)	DRAWN BY: STANTEC
FILE NAME: ...\\zd307c3ero_plans.pft	CHECKED BY: GARY SANTY
DESIGN SUPERVISOR: GREG EDWARDS	SHEET 129 OF 577
DESIGNED BY: MARC FOISY	
<b>EROSION CONTROL PLAN EC-10</b>	

V:\9533\active\95330002\transportation\drawing\contract\_3\plot\_files\zd307c3ero\_plans.pft