

**NOTE:**  
1. FOR FULL DETAIL OF SWALE  
SEE SHEET SWM-4.



**HAY MULCH**  
STA SI 1+011 - SI 1+359, RT & LT  
STA SW 4+001 - SW 4+141, RT  
STA SW 4+001 - SW 4+150, LT

**SEED, WINTER RYE**  
STA SI1+011 - SI1+359, RT & LT  
STA SW 4+001 - SW 4+141, RT  
STA SW 4+001 - SW 4+150, LT

**TEMPORARY EROSION MATTING**  
STA SW 4+005 - SW 4+136, RT  
STA SW 4+009 - SW 4+136, LT

**VEHICLE TRACKING PAD**  
STA SW 4+006, LT

**MATCH LINE**  
SEE SHEET EC-10

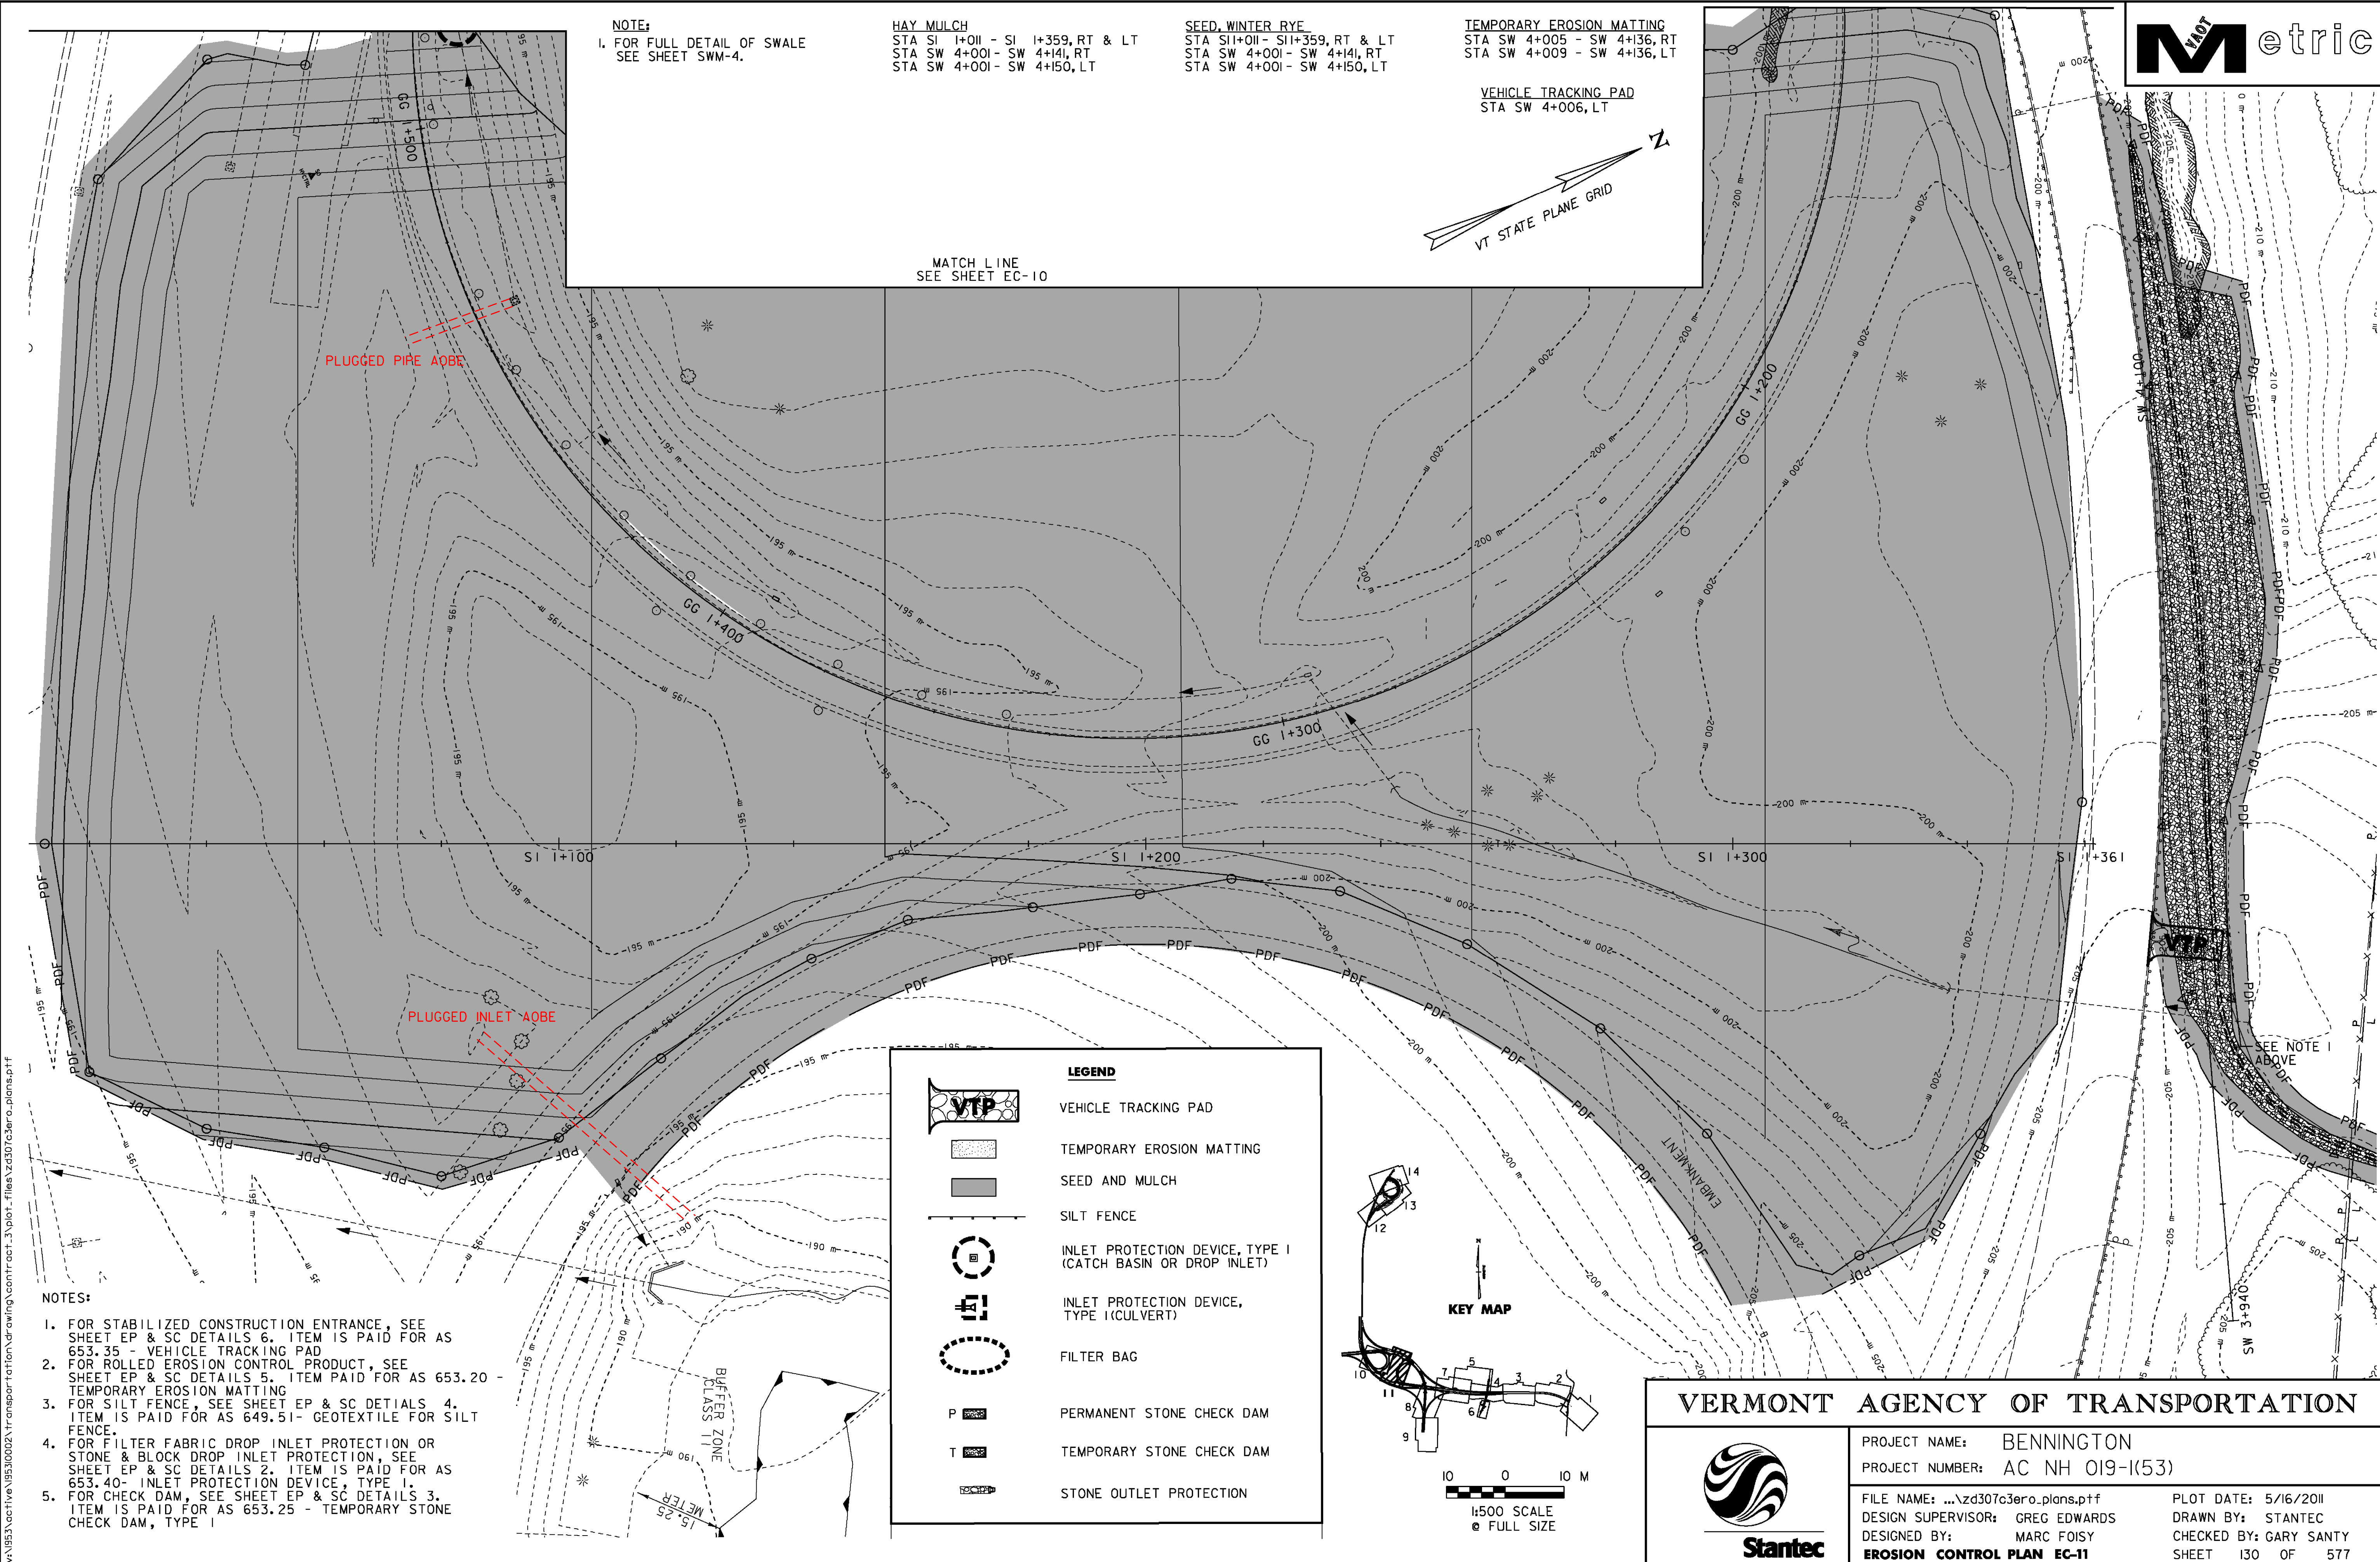
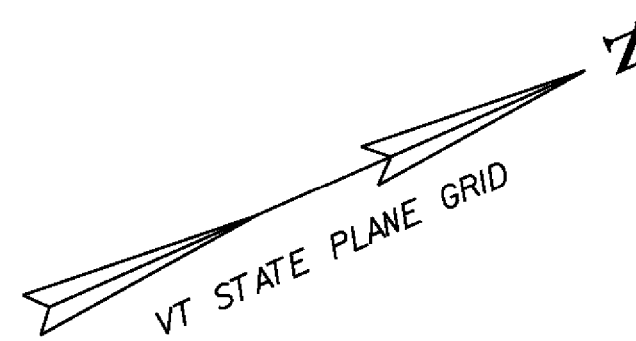


**NOTES:**

1. FOR STABILIZED CONSTRUCTION ENTRANCE, SEE SHEET EP & SC DETAILS 6. ITEM IS PAID FOR AS 653.35 - VEHICLE TRACKING PAD
2. FOR ROLLED EROSION CONTROL PRODUCT, SEE SHEET EP & SC DETAILS 5. ITEM PAID FOR AS 653.20 - TEMPORARY EROSION MATTING
3. FOR SILT FENCE, SEE SHEET EP & SC DETAILS 4. ITEM IS PAID FOR AS 649.51 - GEOTEXTILE FOR SILT FENCE.
4. FOR FILTER FABRIC DROP INLET PROTECTION OR STONE & BLOCK DROP INLET PROTECTION, SEE SHEET EP & SC DETAILS 2. ITEM IS PAID FOR AS 653.40 - INLET PROTECTION DEVICE, TYPE 1.
5. FOR CHECK DAM, SEE SHEET EP & SC DETAILS 3. ITEM IS PAID FOR AS 653.25 - TEMPORARY STONE CHECK DAM, TYPE 1

**LEGEND**

- VTP VEHICLE TRACKING PAD
- TEMPORARY EROSION MATTING
- SEED AND MULCH
- SILT FENCE
- INLET PROTECTION DEVICE, TYPE I (CATCH BASIN OR DROP INLET)
- INLET PROTECTION DEVICE, TYPE I (CULVERT)
- FILTER BAG
- PERMANENT STONE CHECK DAM
- TEMPORARY STONE CHECK DAM
- STONE OUTLET PROTECTION

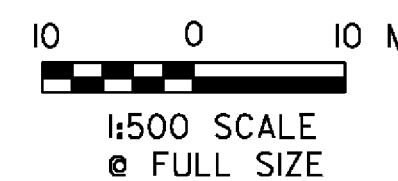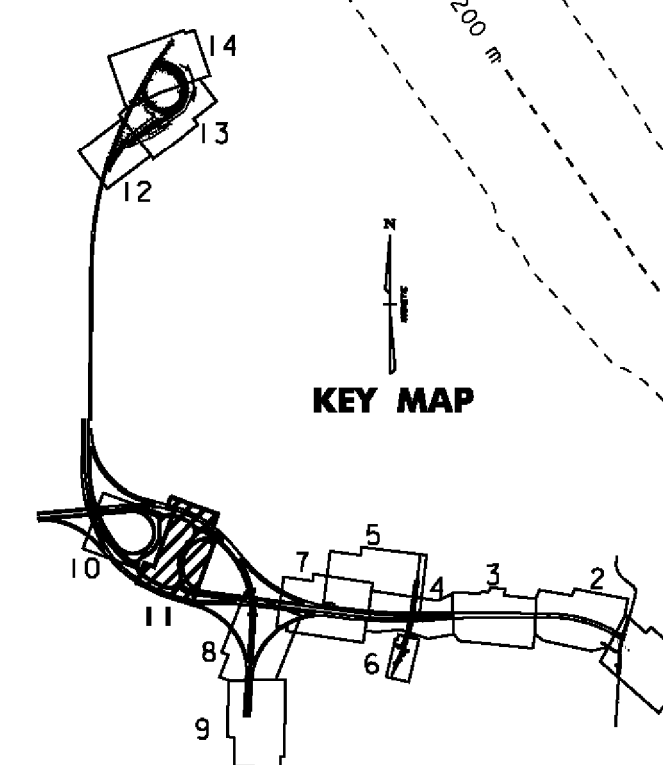

**VERMONT AGENCY OF TRANSPORTATION**



PROJECT NAME: BENNINGTON  
PROJECT NUMBER: AC NH 019-(153)

FILE NAME: ...z307c3ero.plans.ptf  
DESIGN SUPERVISOR: GREG EDWARDS  
DESIGNED BY: MARC FOISY  
**EROSION CONTROL PLAN EC-11**

PLOT DATE: 5/16/2011  
DRAWN BY: STANTEC  
CHECKED BY: GARY SANTY  
SHEET 130 OF 577

V:\1953\vehicle\19530002\transportation\drawing\contract\3\plot\_files\z307c3ero.plans.ptf