


LEGEND	
	VEHICLE TRACKING PAD
	TEMPORARY EROSION MATTING
	SEED AND MULCH
	SILT FENCE
	INLET PROTECTION DEVICE, TYPE I (CATCH BASIN OR DROP INLET)
	INLET PROTECTION DEVICE, TYPE I (CULVERT)
	FILTER BAG
	PERMANENT STONE CHECK DAM
	TEMPORARY STONE CHECK DAM
	STONE OUTLET PROTECTION

<b>TEMPORARY EROSION MATTING</b> STA. A 1+540.0 - A 1+723.3, RT. STA. B 1+000.0 - B 1+171.4, RT. STA. B 1+435.0 - B 1+515.3, RT. STA. B 1+435.0 - B 1+466.0, LT.	<b>SEED, WINTER RYE</b> STA. A 1+540 - A 1+705, RT. <b>HAY MULCH</b> STA. A 1+540 - A 1+705, RT.	<b>INLET PROTECTION DEVICE, TYPE I (CATCH BASIN)</b> STA. A 1+695, RT. STA. B 1+038, LT. STA. B 1+038, RT. STA. B 1+136, LT. STA. B 1+136, RT.
<b>VEHICLE TRACKING PAD</b> STA. A 1+666, 112 m RT.	<b>TEMPORARY STONE CHECK DAMS</b> STA. A 1+680 - STA. A 1+780, RT.	<b>INLET PROTECTION - STEEL PLATE</b> STA. A 1+581, LT.

- NOTES:
- FOR STABILIZED CONSTRUCTION ENTRANCE, SEE SHEET EP & SC DETAILS 6. ITEM IS PAID FOR AS 653.35 - VEHICLE TRACKING PAD
  - FOR ROLLED EROSION CONTROL PRODUCT, SEE SHEET EP & SC DETAILS 5. ITEM PAID FOR AS 653.20 - TEMPORARY EROSION MATTING
  - FOR SILT FENCE, SEE SHEET EP & SC DETAILS 4. ITEM IS PAID FOR AS 649.51 - GEOTEXTILE FOR SILT FENCE.
  - FOR FILTER FABRIC DROP INLET PROTECTION OR STONE & BLOCK DROP INLET PROTECTION, SEE SHEET EP & SC DETAILS 2. ITEM IS PAID FOR AS 653.40- INLET PROTECTION DEVICE, TYPE I.
  - FOR CHECK DAM, SEE SHEET EP & SC DETAILS 3. ITEM IS PAID FOR AS 653.25 - TEMPORARY STONE CHECK DAM, TYPE I
  - IT SHALL BE THE RESPONSIBILITY OF THE CONTRACTOR TO PROTECT AND MAINTAIN THE EXISTING CURBED MEDIAN DURING CONSTRUCTION. ANY DAMAGE TO THE CURBED MEDIAN INCLUDING, BUT NOT LIMITED TO, THE MOUNTABLE STONE CURB, TURF, GUARDRAIL AND DRAINAGE STRUCTURES SHALL BE RESTORED/REPLACED BY THE CONTRACTOR AT NO ADDITIONAL COST TO THE AGENCY. PRIOR TO THE START OF ANY WORK, THE RESIDENT ENGINEER AND CONTRACTOR SHALL INSPECT THE MEDIAN TO IDENTIFY AND DOCUMENT ANY PRE-EXISTING PROBLEMS AND/OR CONDITIONS.
  - FOR DETAILS ON PROTECTING THE EXISTING CATCH BASINS DURING THE ROCK CUT OPERATIONS, SEE DRAWING DD-3.
  - FOR EROSION CONTROL GENERAL NOTES AND DETAILS, SEE DRAWING EC-1
  - THE CONTRACTOR HAS THE OPTION OF USING EXCAVATED ROCK FOR STONE FILL, TYPE II (ITEM 613.11). THE EXCAVATED ROCK SHALL MEET THE GRADATION REQUIREMENTS OF STANDARD SPECIFICATION SECTION 706.04.

MATCH LINE STA. B 1+435, SEE SHEET EC-13


MATCH LINE STA. A 1+540, STA. B 1+171.403, SEE SHEET EC-13

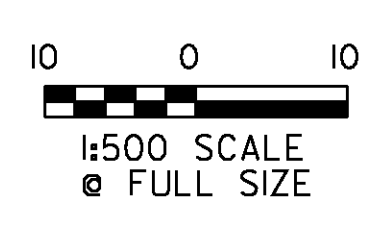

**VERMONT AGENCY OF TRANSPORTATION**



PROJECT NAME: BENNINGTON	PLOT DATE: 5/16/2011
PROJECT NUMBER: AC NH 019-(153)	DRAWN BY: STANTEC
FILE NAME: ...\\zd307c3ero_plans.pff	CHECKED BY: GARY SANTY
DESIGN SUPERVISOR: GREG EDWARDS	SHEET 133 OF 577
DESIGNED BY: MARC FOISY	
<b>EROSION CONTROL PLAN EC-14</b>	

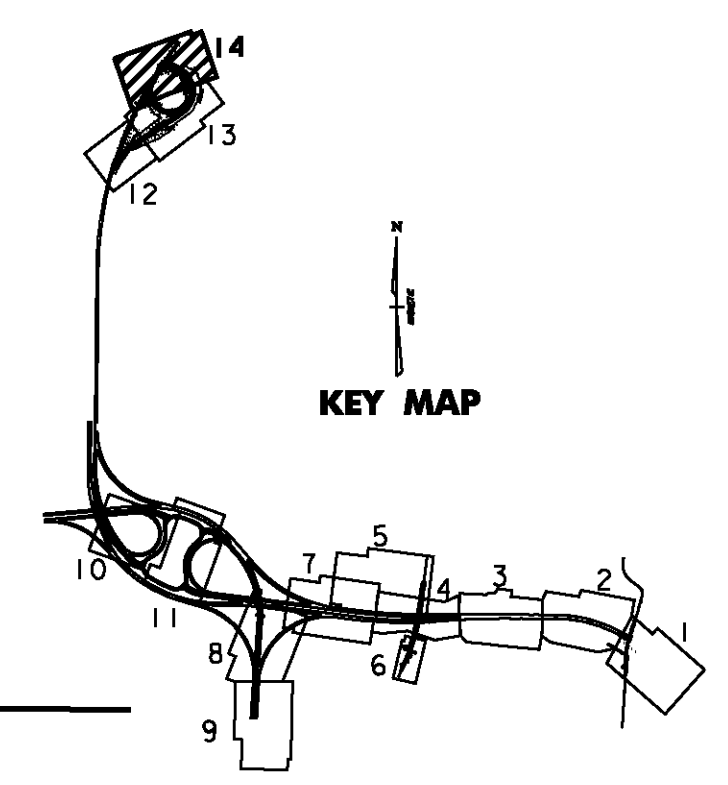

V:\953\active\9530002\transportation\drawing\contract\_3\plot\_files\zd307c3ero\_plans.pff