

NOTES

1. FOR ALL PAVEMENT MARKING DETAILS, SEE VTRANS STANDARDS E-191, E-192, & E-193.
2. FOR LOCATION OF CHEVRONS SEE VTRANS STANDARD E-126.


DURABLE 150 YELLOW LINE, THERMOPLASTIC
STA. G 1+295.4 TO STA. G 1+748.6, SOLID LT.

DURABLE 150 WHITE LINE, THERMOPLASTIC
STA. G 1+295.4 TO STA. G 1+748.6, SOLID RT.


DELINEATOR WITH STEEL POST
AS SHOWN - 29
SEE VTRANS STD. E-197 FOR DETAILS

REMOVAL OF EXISTING DELINEATOR
AS SHOWN - 24

REMOVING SIGNS
AS SHOWN - 6

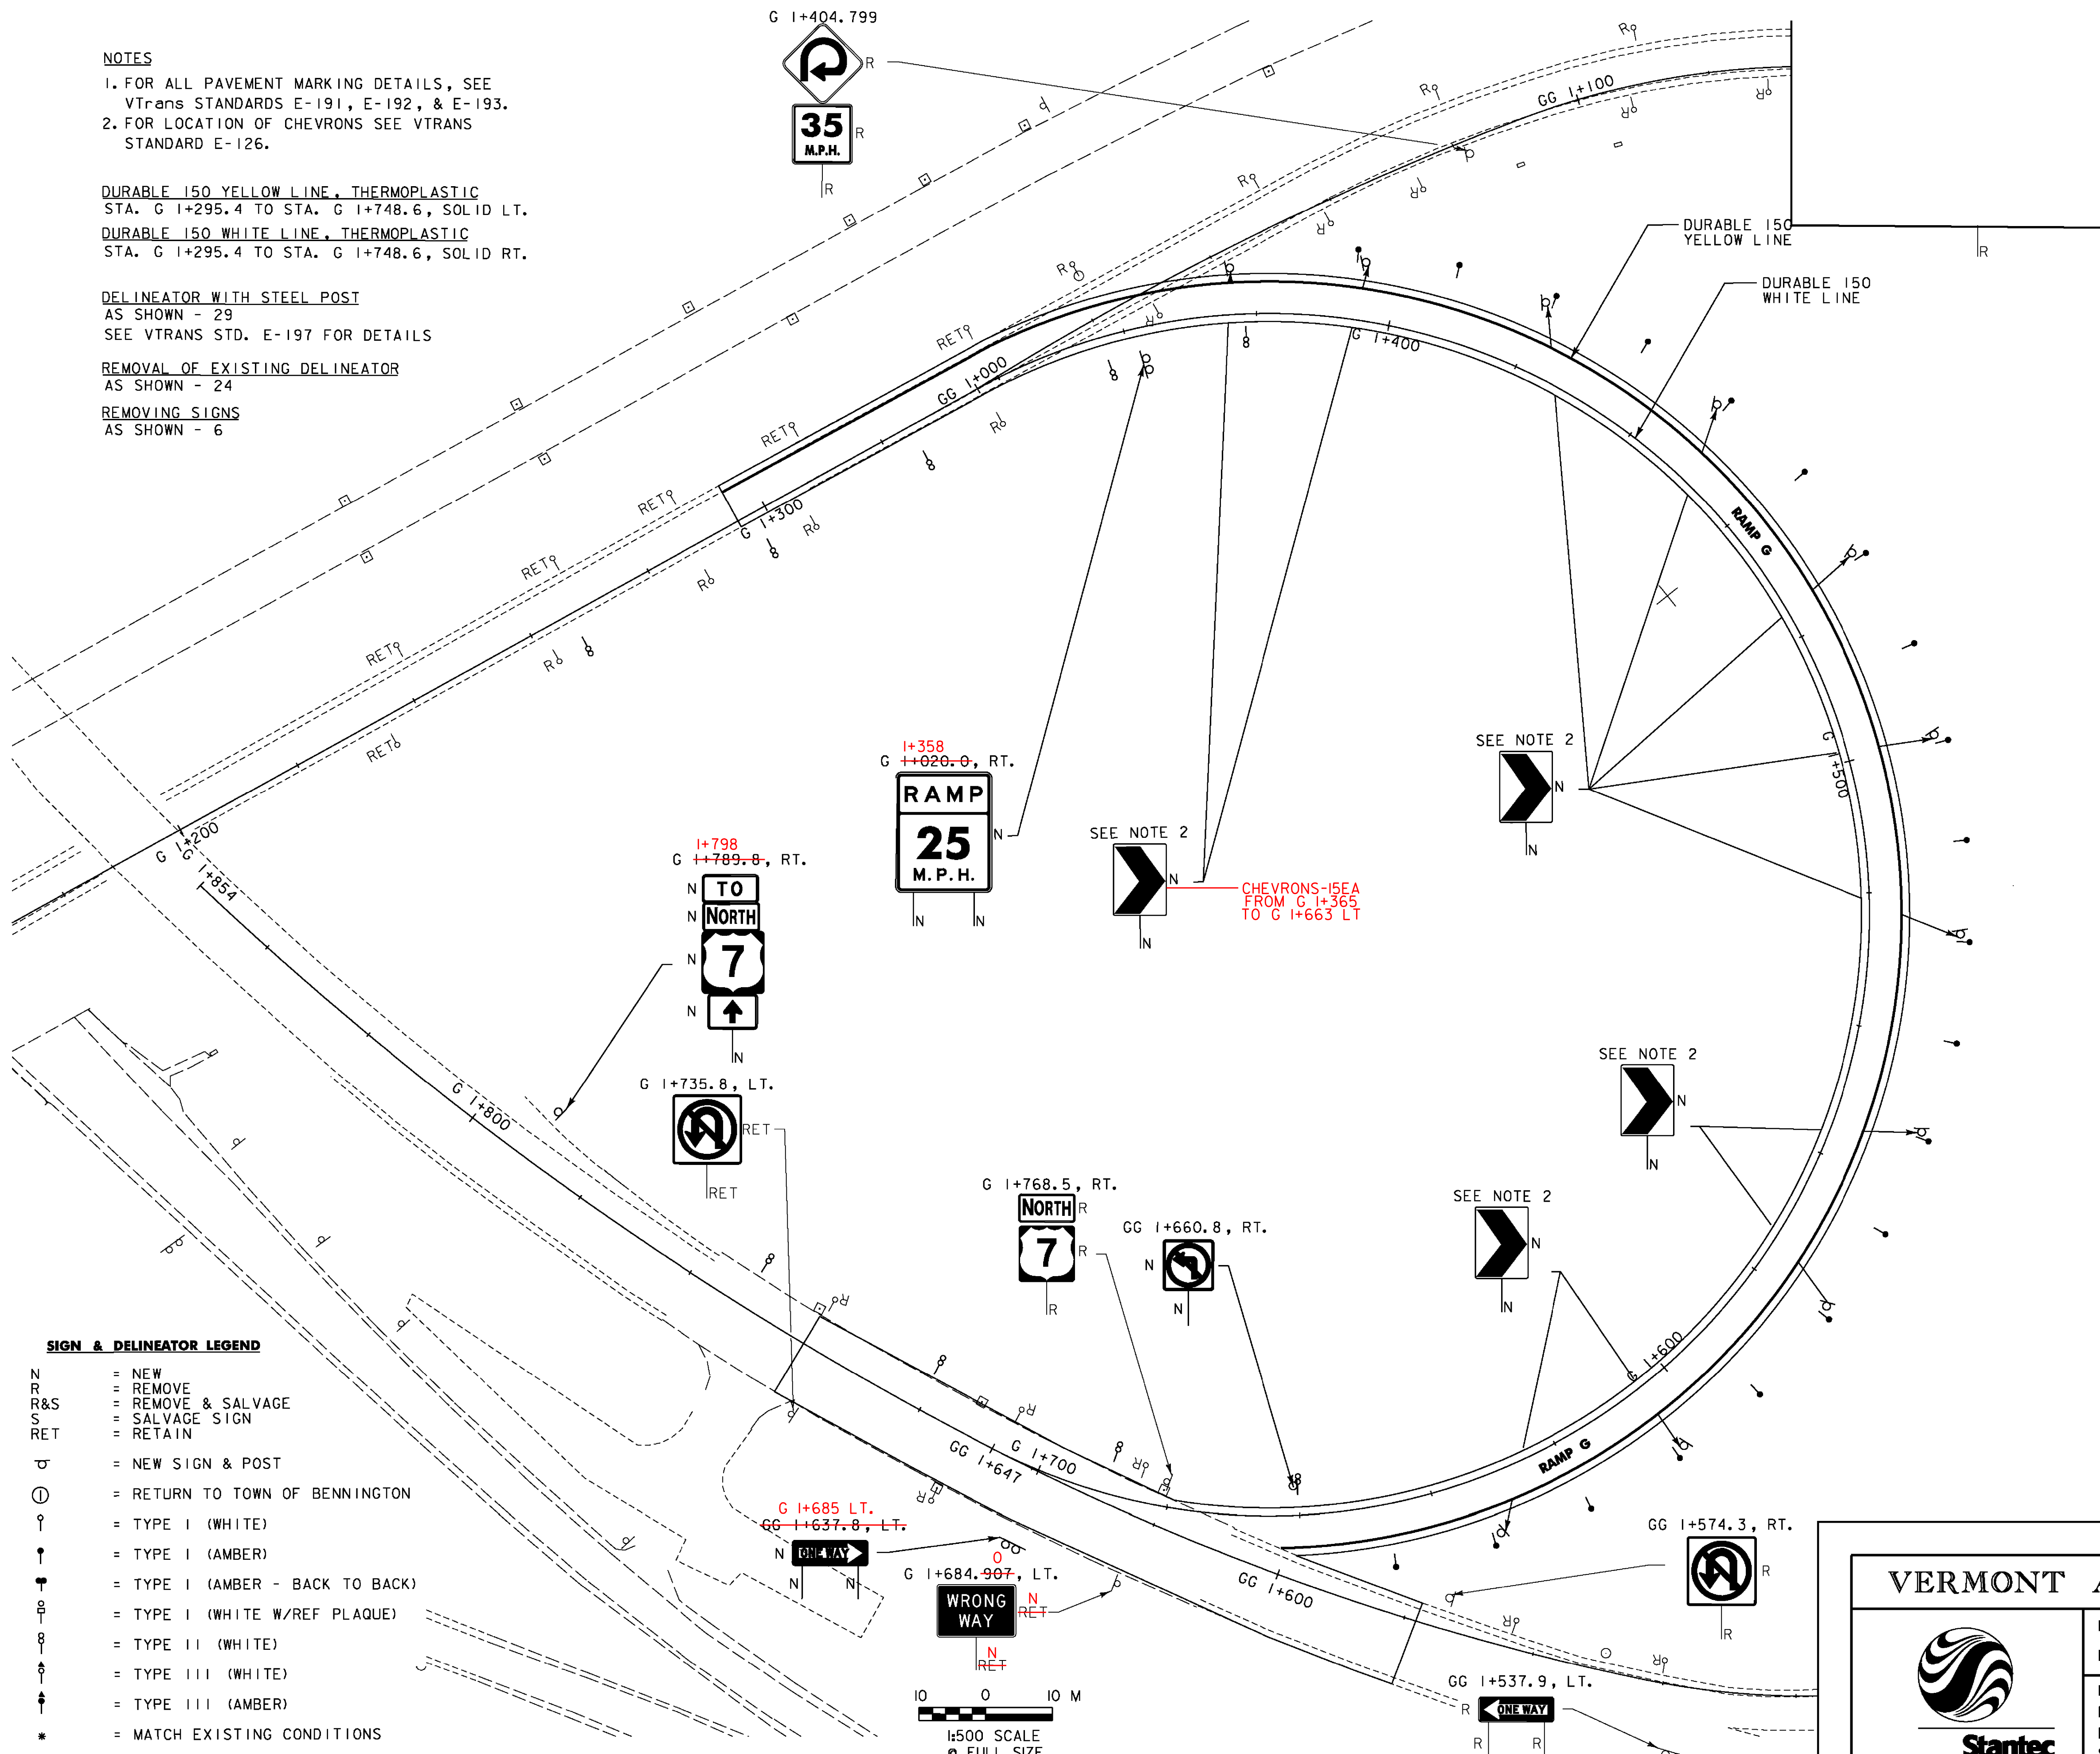


MATCH LINE, SEE SHEET SP-05

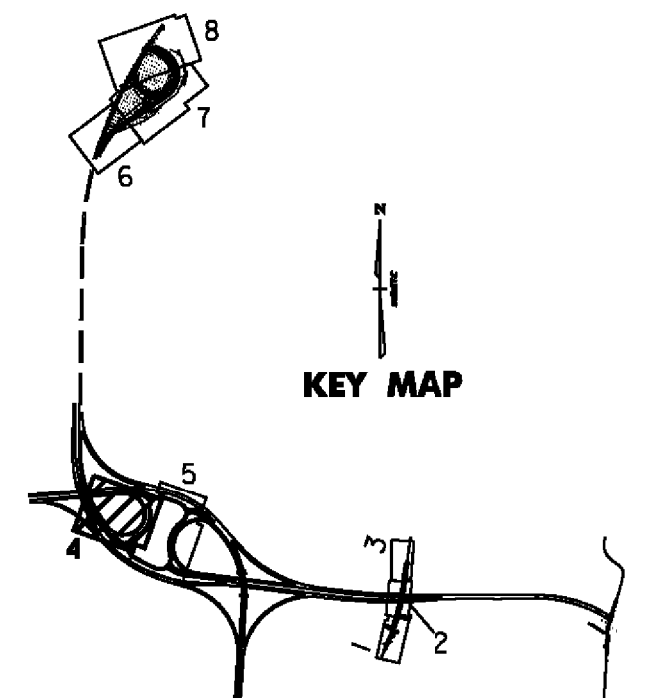

NOTE: ALL DIMENSIONS ARE IN MILLIMETERS (mm) EXCEPT WHERE NOTED.

SIGN & DELINEATOR LEGEND

N	= NEW
R	= REMOVE
R&S	= REMOVE & SALVAGE
S	= SALVAGE SIGN
RET	= RETAIN
⊕	= NEW SIGN & POST
⊙	= RETURN TO TOWN OF BENNINGTON
○	= TYPE I (WHITE)
●	= TYPE I (AMBER)
⊖	= TYPE I (AMBER - BACK TO BACK)
⊕	= TYPE I (WHITE W/REF PLAQUE)
⊙	= TYPE II (WHITE)
●	= TYPE III (WHITE)
⊖	= TYPE III (AMBER)
*	= MATCH EXISTING CONDITIONS

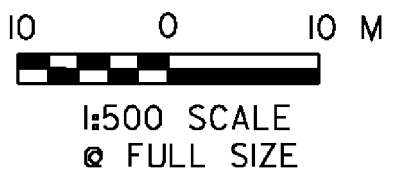

VERMONT AGENCY OF TRANSPORTATION



PROJECT NAME:	BENNINGTON
PROJECT NUMBER:	AC NH 019-(K53)
FILE NAME:	...z307c3sgn.plans.ptf
DESIGN SUPERVISOR:	GREG EDWARDS
DESIGNED BY:	MARC FOISY
SIGNS, MARKINGS & DELINEATORS SP-04	
PLOT DATE:	5/16/2011
DRAWN BY:	STANTEC
CHECKED BY:	GARY SANTY
SHEET	147 OF 577

vr:\953\active\9530002\transportation\drawing\contract\3\p01_files\z307c3sgn_plans.ptf