
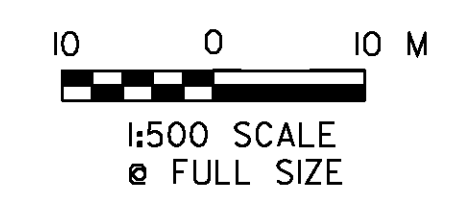
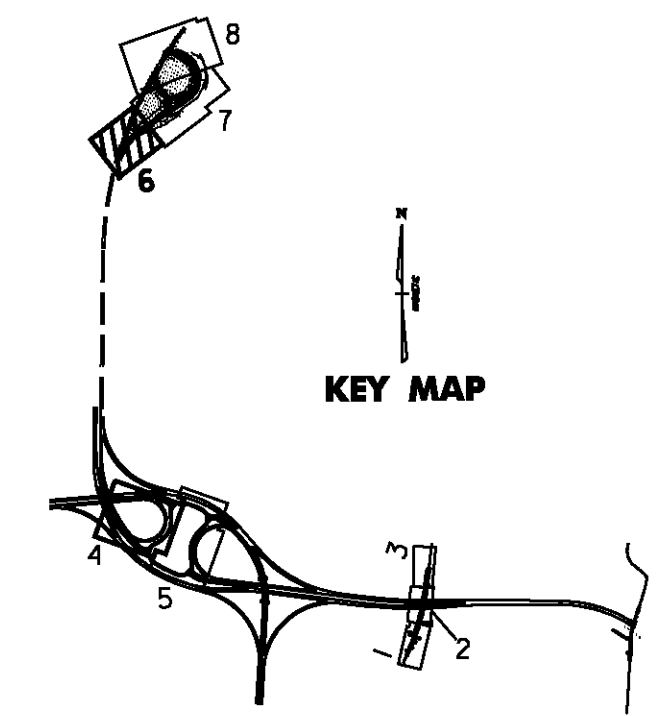
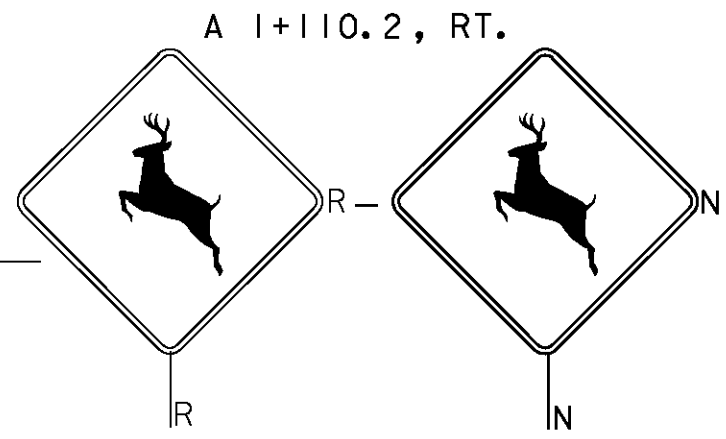


**STA. A 1+095.000  
BEGIN CONSTRUCTION  
BEGIN COLD PLANING  
AND RESURFACING**

MATCH LINE STA. A 1+220, SEE SHEET SP-07

- SIGN & DELINEATOR LEGEND**
- N = NEW
  - R = REMOVE
  - R&S = REMOVE & SALVAGE
  - S = SALVAGE SIGN
  - RET = RETAIN
  - ⊕ = NEW SIGN & POST
  - ⊙ = RETURN TO TOWN OF BENNINGTON
  - ⌈ = TYPE I (WHITE)
  - ⌋ = TYPE I (AMBER)
  - ⌌ = TYPE I (AMBER - BACK TO BACK)
  - ⌍ = TYPE I (WHITE W/REF PLAQUE)
  - ⌎ = TYPE II (WHITE)
  - ⌏ = TYPE III (WHITE)
  - ⌐ = TYPE III (AMBER)
  - \* = MATCH EXISTING CONDITIONS

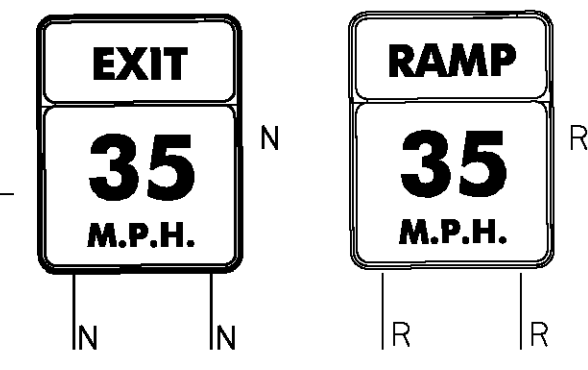


**NOTES**  
1. FOR ALL PAVEMENT MARKING DETAILS, SEE VTrans STANDARDS E-191, E-192, & E-193.

**DURABLE 150 YELLOW LINE, THERMOPLASTIC**  
STA. A 1+095.1 TO STA. A 1+220.0, SOLID LT.  
**DURABLE 150 WHITE LINE, THERMOPLASTIC**  
STA. A 1+095.1 TO STA. A 1+220.0, SOLID RT.

**REMOVAL OF EXISTING DELINEATORS**  
AS SHOWN - 12  
**DELINEATORS W/ STEEL POSTS**  
AS SHOWN - 10  
SEE VTrans STD. E-197 FOR DETAILS  
**REMOVING SIGNS**  
AS SHOWN - 4

NOTE: ALL DIMENSIONS ARE IN MILLIMETERS (mm) EXCEPT WHERE NOTED.

<b>VERMONT AGENCY OF TRANSPORTATION</b>	
	PROJECT NAME: BENNINGTON PROJECT NUMBER: AC NH 019-(153)
FILE NAME: ...z307c3sgn_plans.prf DESIGN SUPERVISOR: GREG EDWARDS DESIGNED BY: MARC FOISY <b>SIGNS, MARKINGS &amp; DELINEATORS SP-06</b>	PLOT DATE: 5/16/2011 DRAWN BY: STANTEC CHECKED BY: GARY SANTY SHEET 149 OF 577

V:\9513\active\95130002A\transportation\drawing\contract\3\plot\_files\z307c3sgn\_plans.prf