
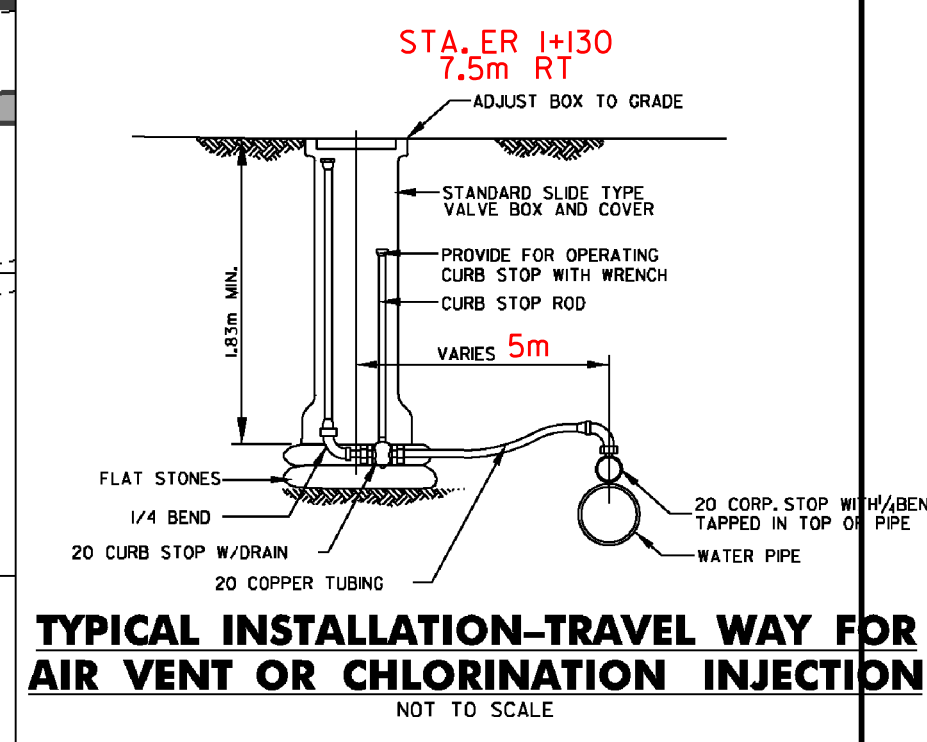
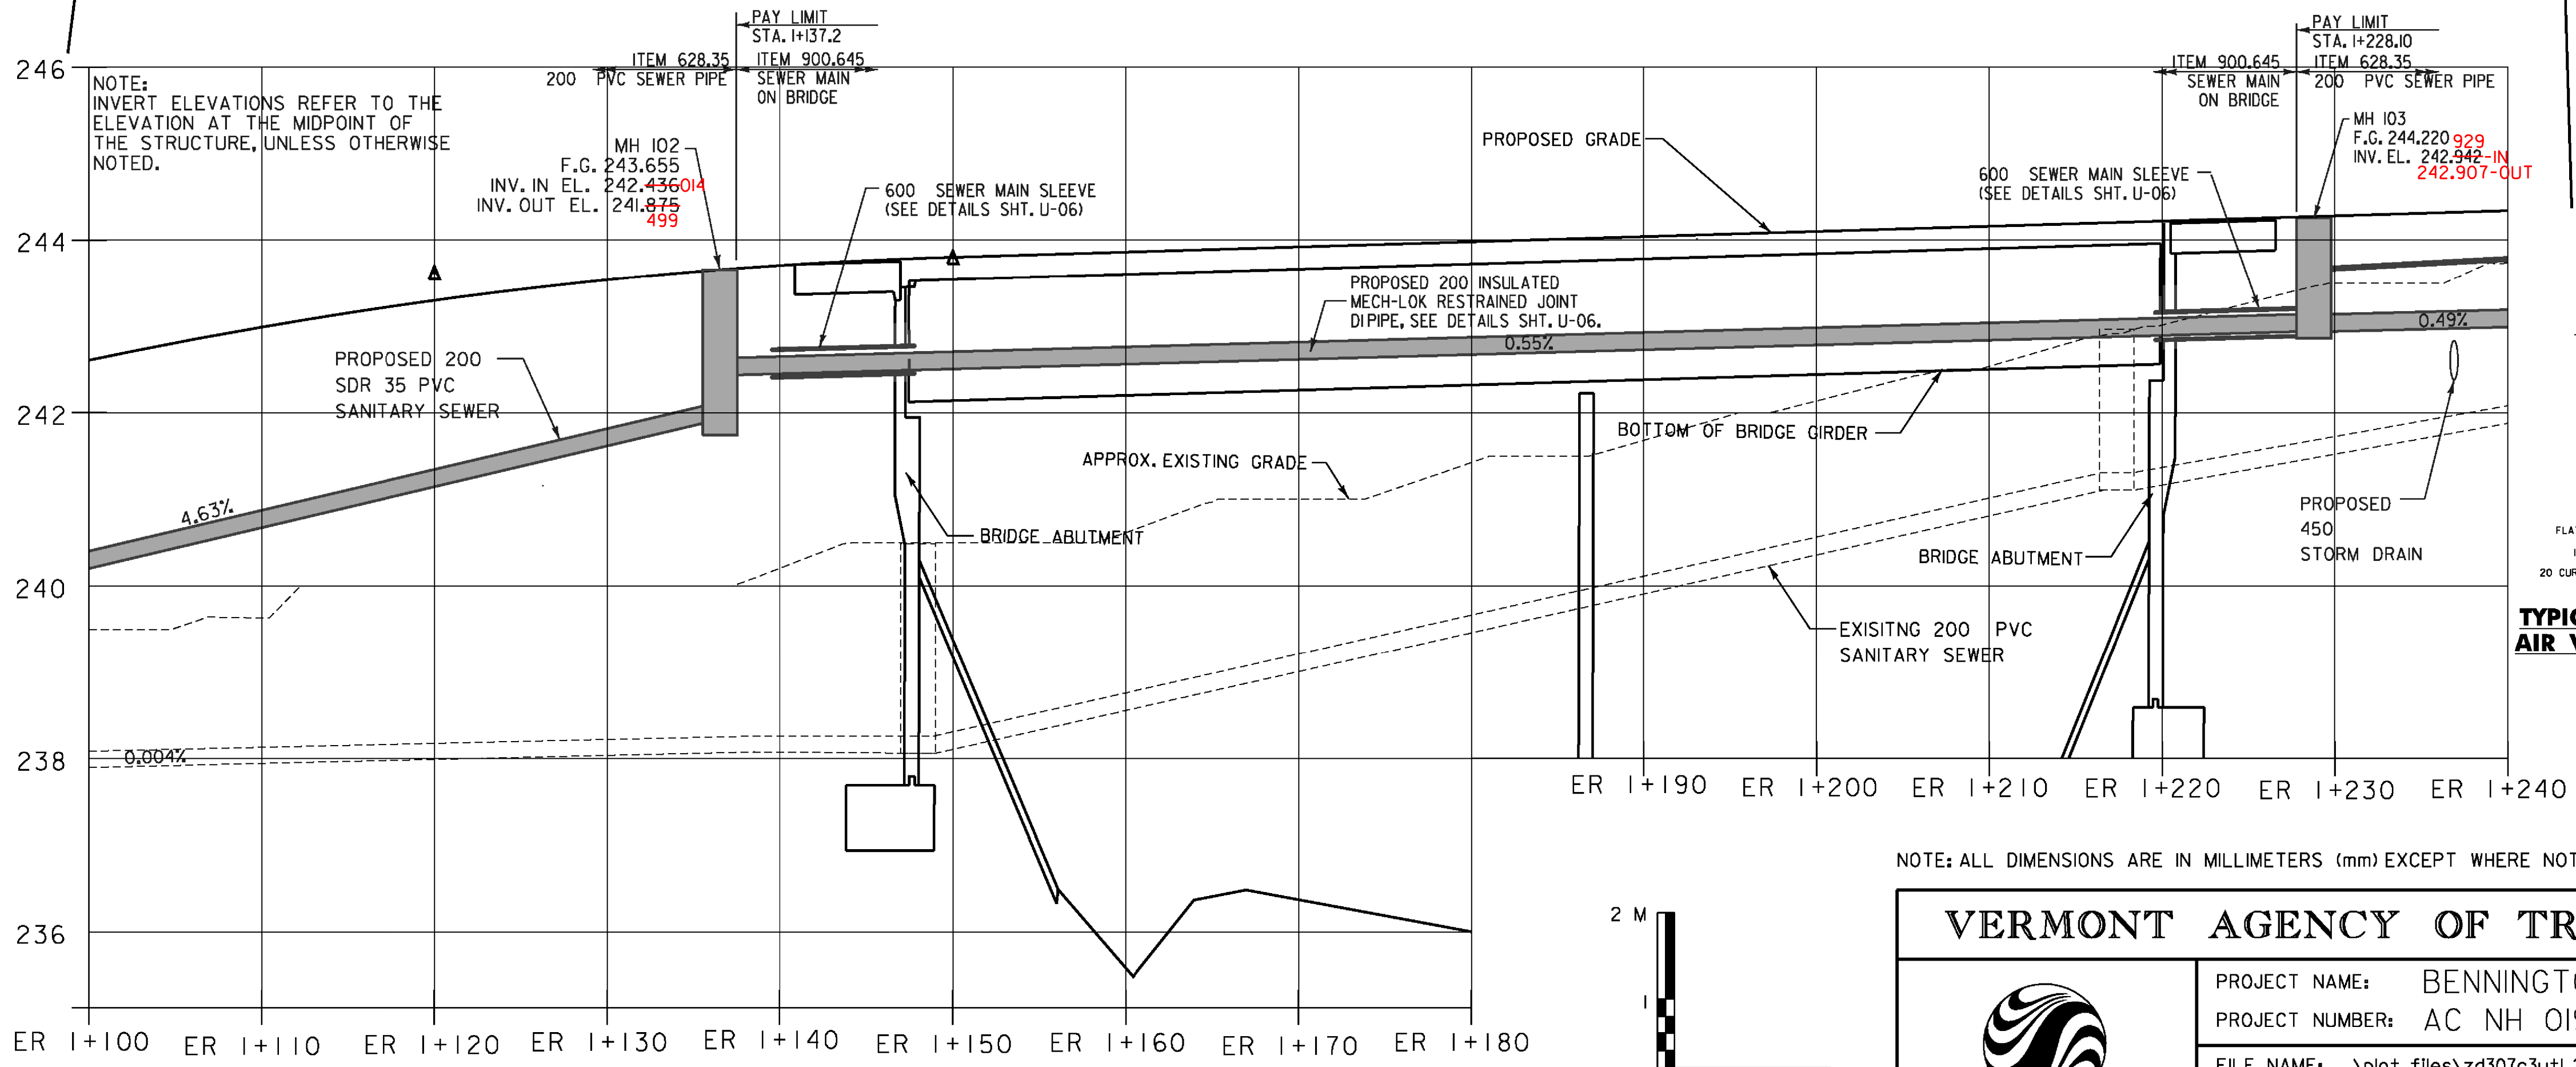
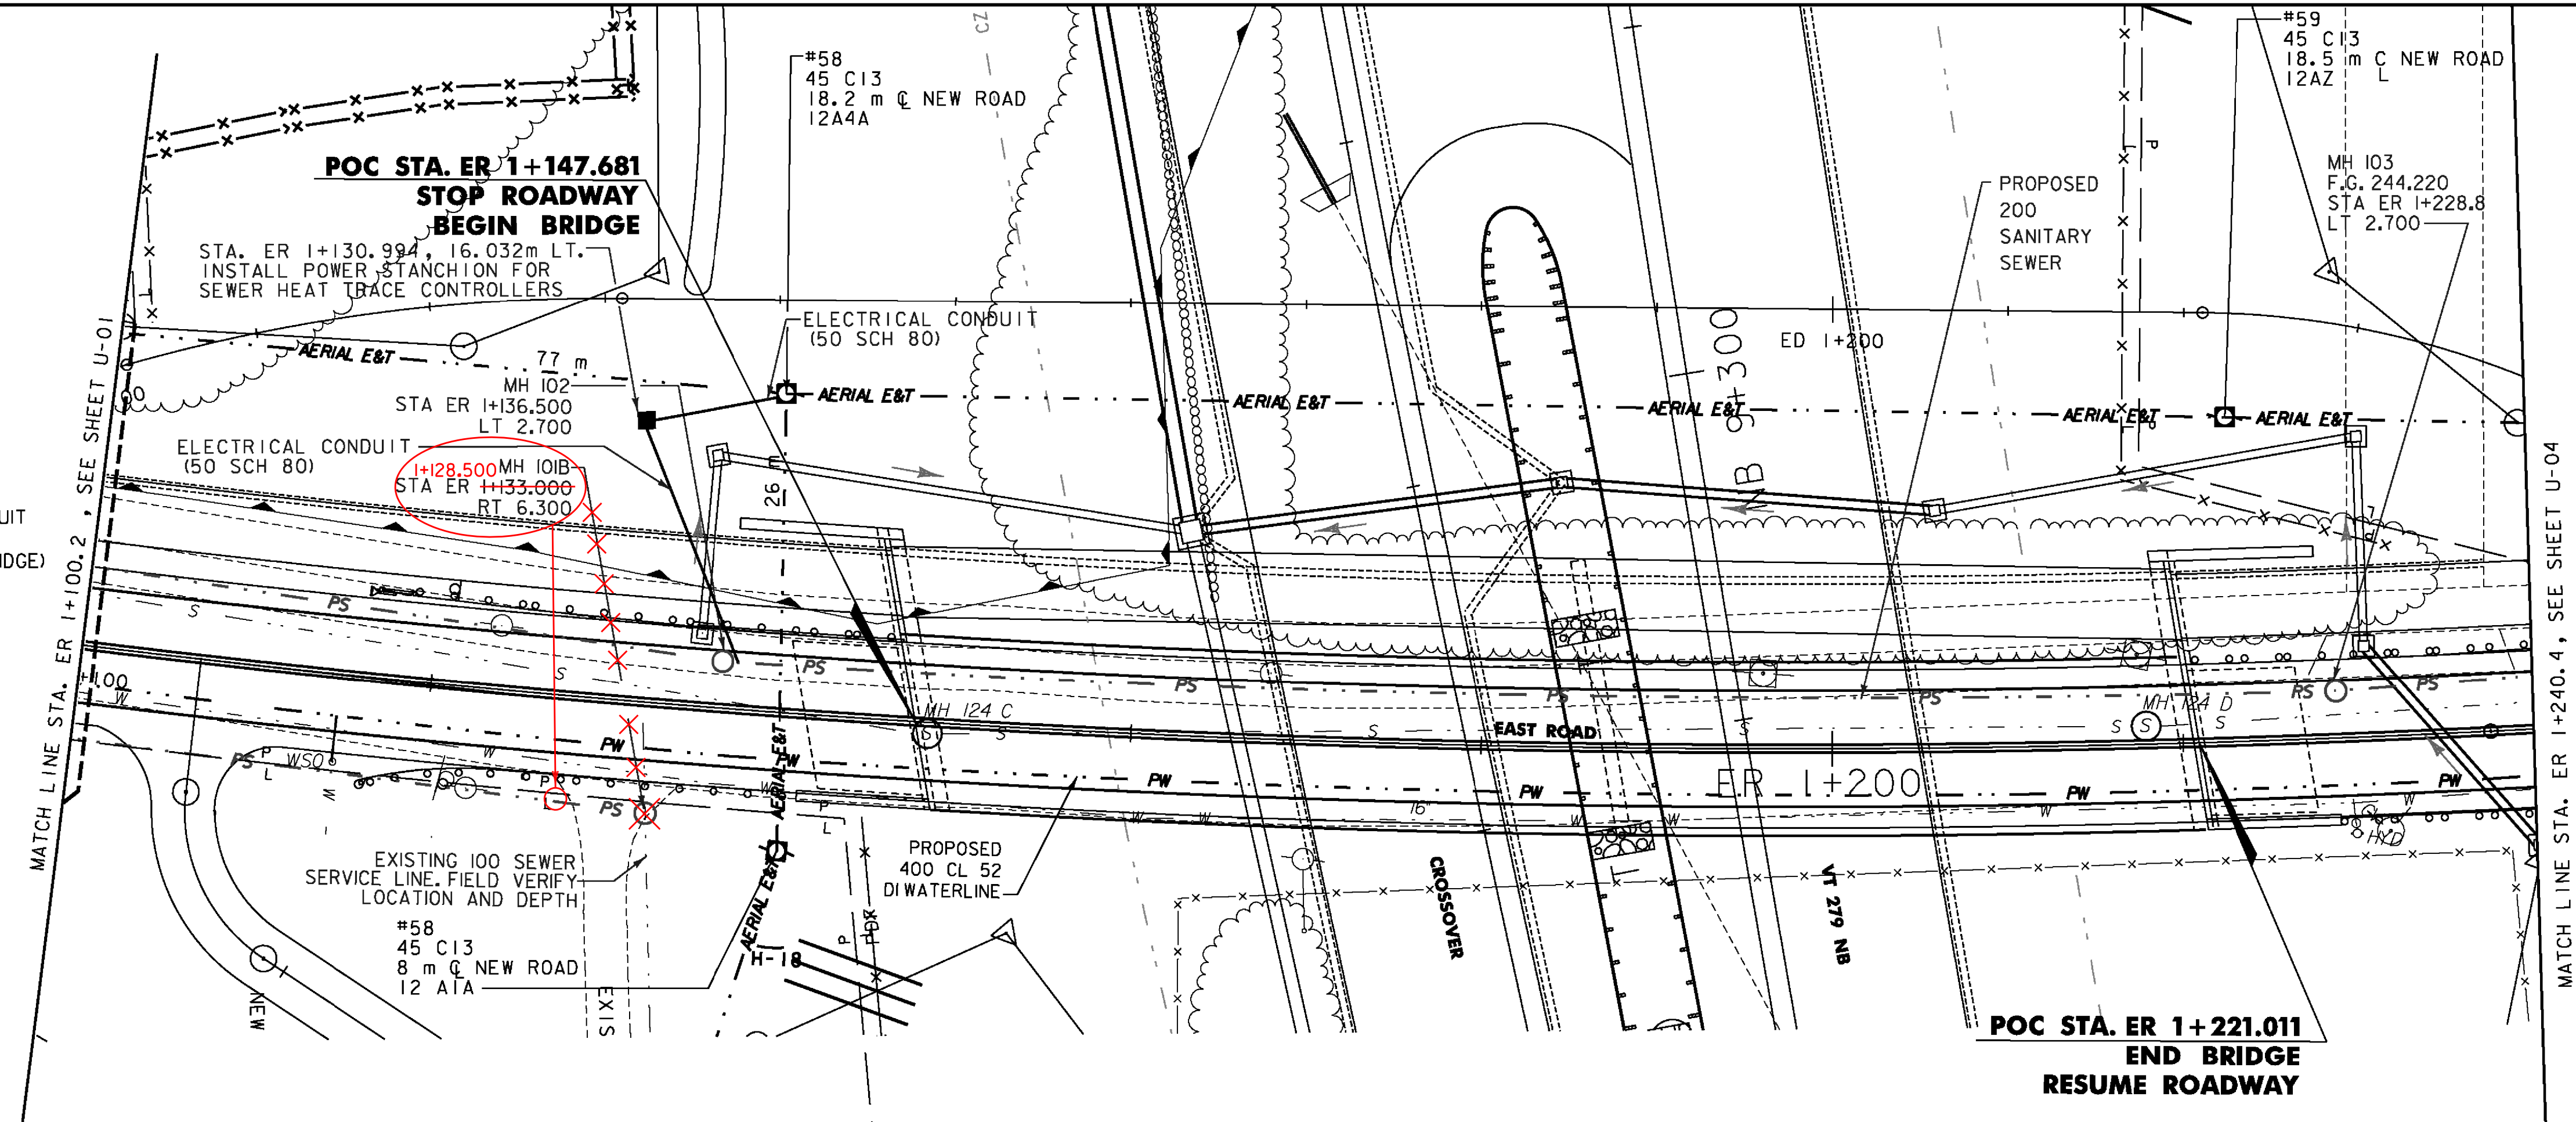


LEGEND


TEMPORARY WATER	-----
TEMPORARY SEWER	-----
PERMANENT WATER	— PW —
PERMANENT SEWER	— PS —
EXISTING WATER	— W —
EXISTING SEWER	— S —

NOTES:

- FOR MORE INFORMATION ON TEMPORARY UTILITY CONNECTIONS SEE SHEETS TC-04 AND TC-05.
- POWER STANCHION, SEWER HEAT TRACE, SEWER HEAT TRACE CONTROLLERS, AND ELECTRICAL CONDUIT (50 SCH 80) SHALL BE PAID INCIDENTAL TO ITEM 900,645 - SPECIAL PROVISION (SEWER MAIN ON BRIDGE) (200 MM).

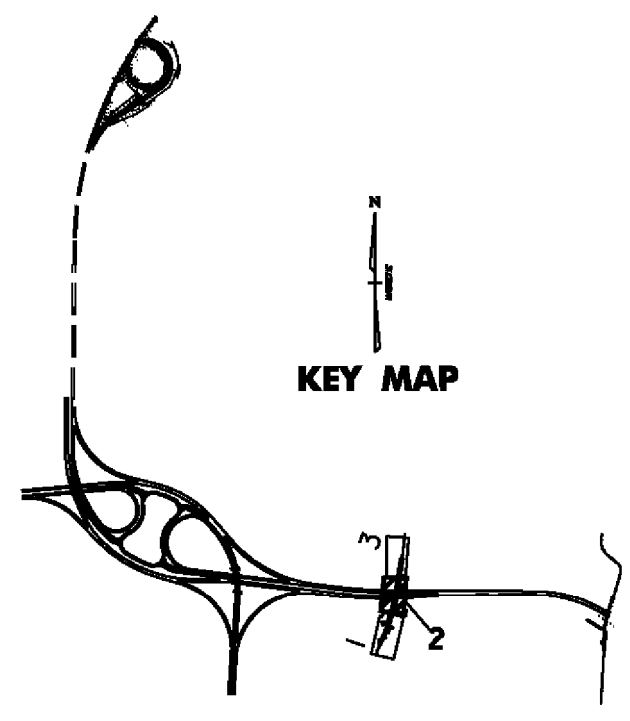

NOTE: ALL DIMENSIONS ARE IN MILLIMETERS (mm) EXCEPT WHERE NOTED.

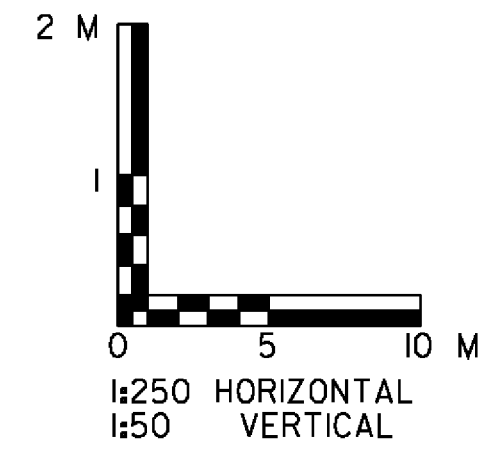

VERMONT AGENCY OF TRANSPORTATION	
	PROJECT NAME: BENNINGTON
	PROJECT NUMBER: AC NH 019-(K53)
FILE NAME: ...\\plot_files\zd30763utl.2.ptf	PLOT DATE: 5/25/2011
DESIGN SUPERVISOR: GREG EDWARDS	DRAWN BY: STANTEC
DESIGNED BY:	CHECKED BY:
UTILITY PLAN U-02	SHEET 156 OF 577

va:\953\active\1953002\transportation\drawing\control\act_3\plot_files\zd30763utl.2.ptf