


ALL ELBOWS WERE 45°

**PROFILE OF WATERLINE
ER 1+100 TO ER 1+240**

NOTE: ALL DIMENSIONS ARE IN MILLIMETERS (mm) EXCEPT WHERE NOTED.

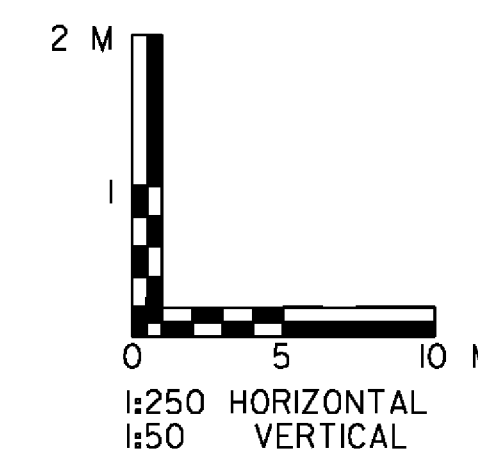

VERMONT AGENCY OF TRANSPORTATION	
	PROJECT NAME: BENNINGTON
	PROJECT NUMBER: AC NH 019-1(53)
	FILE NAME: ...\\plot_files\zd307c3utl3.ppf
	PLOT DATE: 5/25/2011
DESIGN SUPERVISOR: GREG EDWARDS	DRAWN BY: STANTEC
DESIGNED BY: T. KNIGHT	CHECKED BY: M. CHENETTE
UTILITY PLAN U-03	SHEET 157 OF 577

va:\953\active\1953002\transportation\drawing\cont\act-3\plot_files\zd307c3utl3.ppf