


**PROFILE OF HOOD SEWER LINE**

NOTE: ALL DIMENSIONS ARE IN MILLIMETERS (mm) EXCEPT WHERE NOTED.



**VERMONT AGENCY OF TRANSPORTATION**

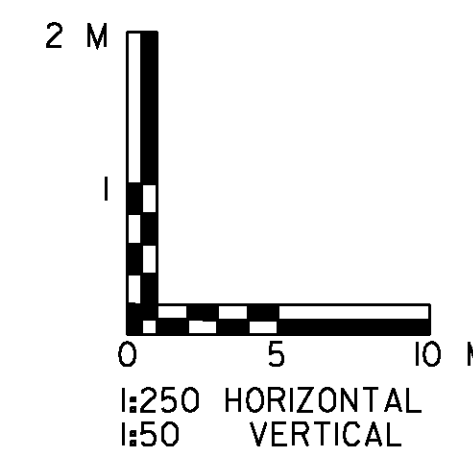

PROJECT NAME: BENNINGTON  
PROJECT NUMBER: AC NH 019-(153)

FILE NAME: ...\\plot\_files\zd307c3utl5.pxf PLOT DATE: 5/25/2011  
DESIGN SUPERVISOR: GREG EDWARDS DRAWN BY: STANTEC  
DESIGNED BY: T. KNIGHT CHECKED BY: M. CHENETTE  
**UTILITY PLAN U-05** SHEET 159 OF 577