


V:\953\eriva\9530002\transportation\drawing\eriva\eriva_3\plot_files\zd307c3xs_east.dwg

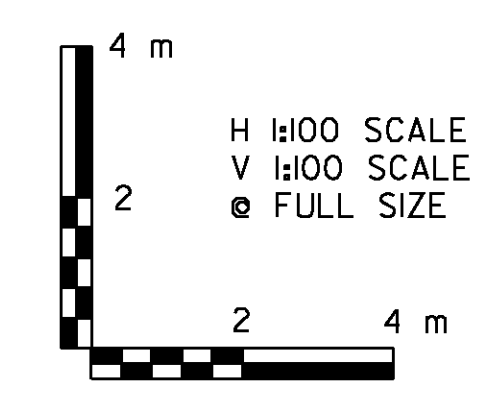

VERMONT AGENCY OF TRANSPORTATION	
	PROJECT NAME: BENNINGTON
	PROJECT NUMBER: AC NH 019-1(53)
DESIGNED BY: MARC FOISY	CHECKED BY: GARY SANTY
FILE NAME: ...plot_files\zd307c3xs_east.dwg	PLOT DATE: 5/26/2011
DESIGN SUPERVISOR: GREG EDWARDS	DRAWN BY: STANTEC
EAST ROAD DETOUR ERD-09	SHEET 177 OF 577