


EXISTING PAVEMENT TO BE CUT  
 AT LIMITS OF PROPOSED CROSS-OVER.  
 ALL EXCESS PAVEMENT SHALL BE REMOVED  
 AND RE SHAPED TO ORIGINAL CONDITION.

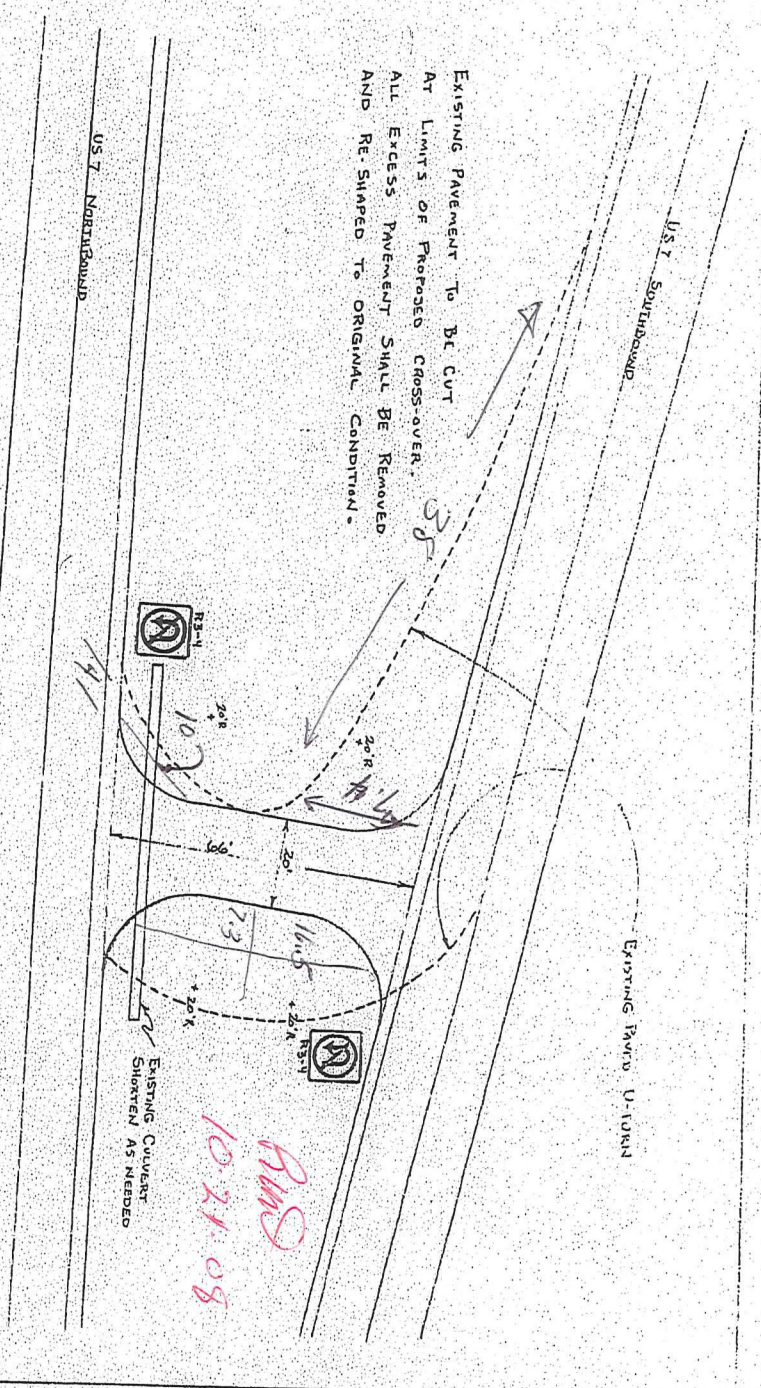

BUNNINGTON: US7  
 Part 2: Deyoung, U-Turns  
 PROPOSED MAINTENANCE CROSS OVER.  
 SCALE: 1" = 20'