


X RAIL EXPANSION JOINT OR SPLICE SHALL BE LOCATED 610 mm FROM CENTERLINE OF INDICATED POST, ON BRIDGE EXPANSION JOINT (ABUTMENT) SIDE OF POST.

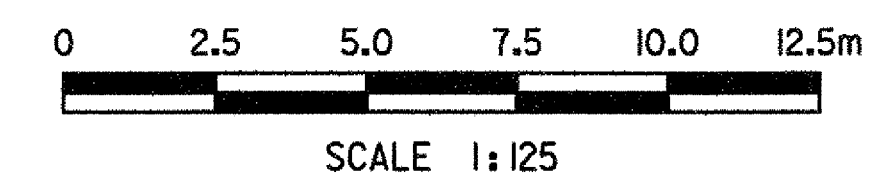

SEE ALSO SHOP DRAWINGS

**NOTES:**

- FOR NETC 2-RAIL BRIDGE RAILING DETAILS AND INFORMATION ABOUT THE NETC GUARD RAIL APPROACH SECTION, SEE SHEETS BR540 THROUGH BR543.
- ITEM 616.28 'CAST-IN-PLACE CONCRETE CURB, TYPE B' SHALL BE PLACED ADJACENT TO EACH APPROACH SLAB QUADRANT. SEE GUARD RAIL APPROACH SECTION, NETC 2 RAIL, BRIDGE SHEETS BR541 AND BR542 FOR DETAILS.



**STATE OF VERMONT AGENCY OF TRANSPORTATION**

Town Of	BENNINGTON	Bridge No.	BI2
Highway No.	VT RTE 279	Log Sta.	
		Surv. Sta.	
VT ROUTE 279 OVER FURNACE BROOK			
<b>RAILING LAYOUT</b>			
Designed By	J.T. DEPLANCHE	Drawn By	D.S. URBINO
Checked By	B.J. CARLSON	Date	04/07
		Bridge Design Supervisor	K.M. WOJTKOWSKI Date 04/07
PROJECT	BENNINGTON	PROJECT NO.	AC NH FO19-(K53)
TVGA CAD Drawing No.	FBRail.dgn	Date	04/10/2007
Bridge Sheet No.	BR515	Sheet	207 of 577