
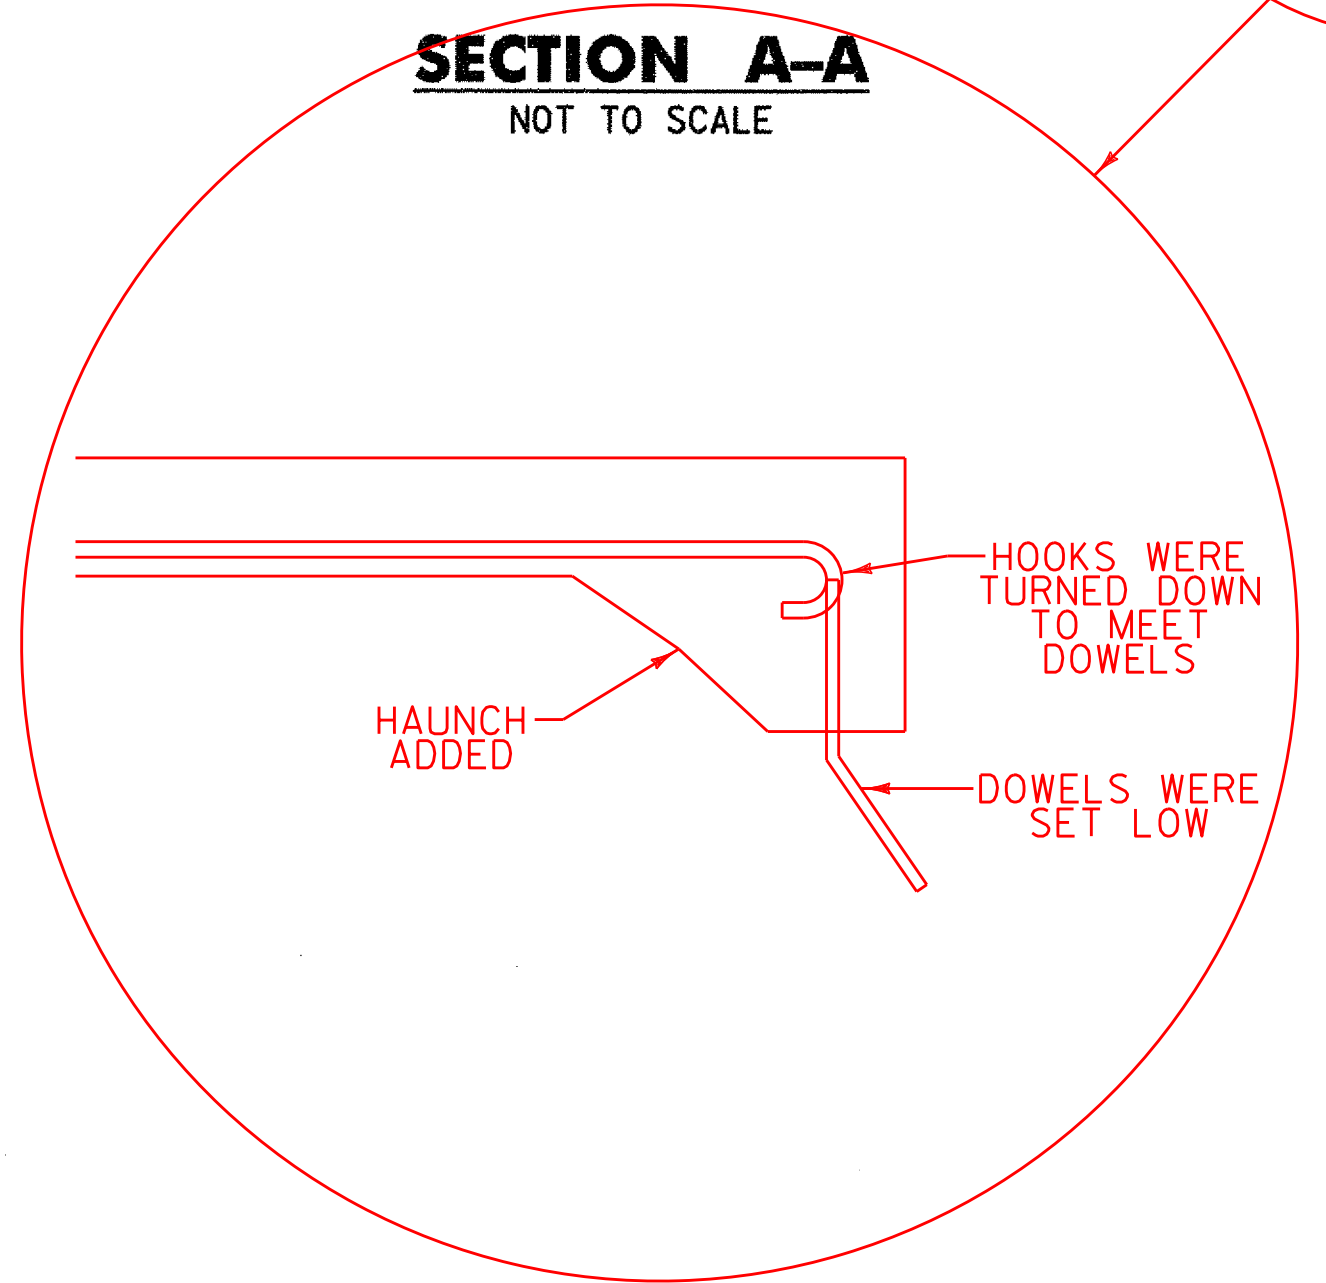
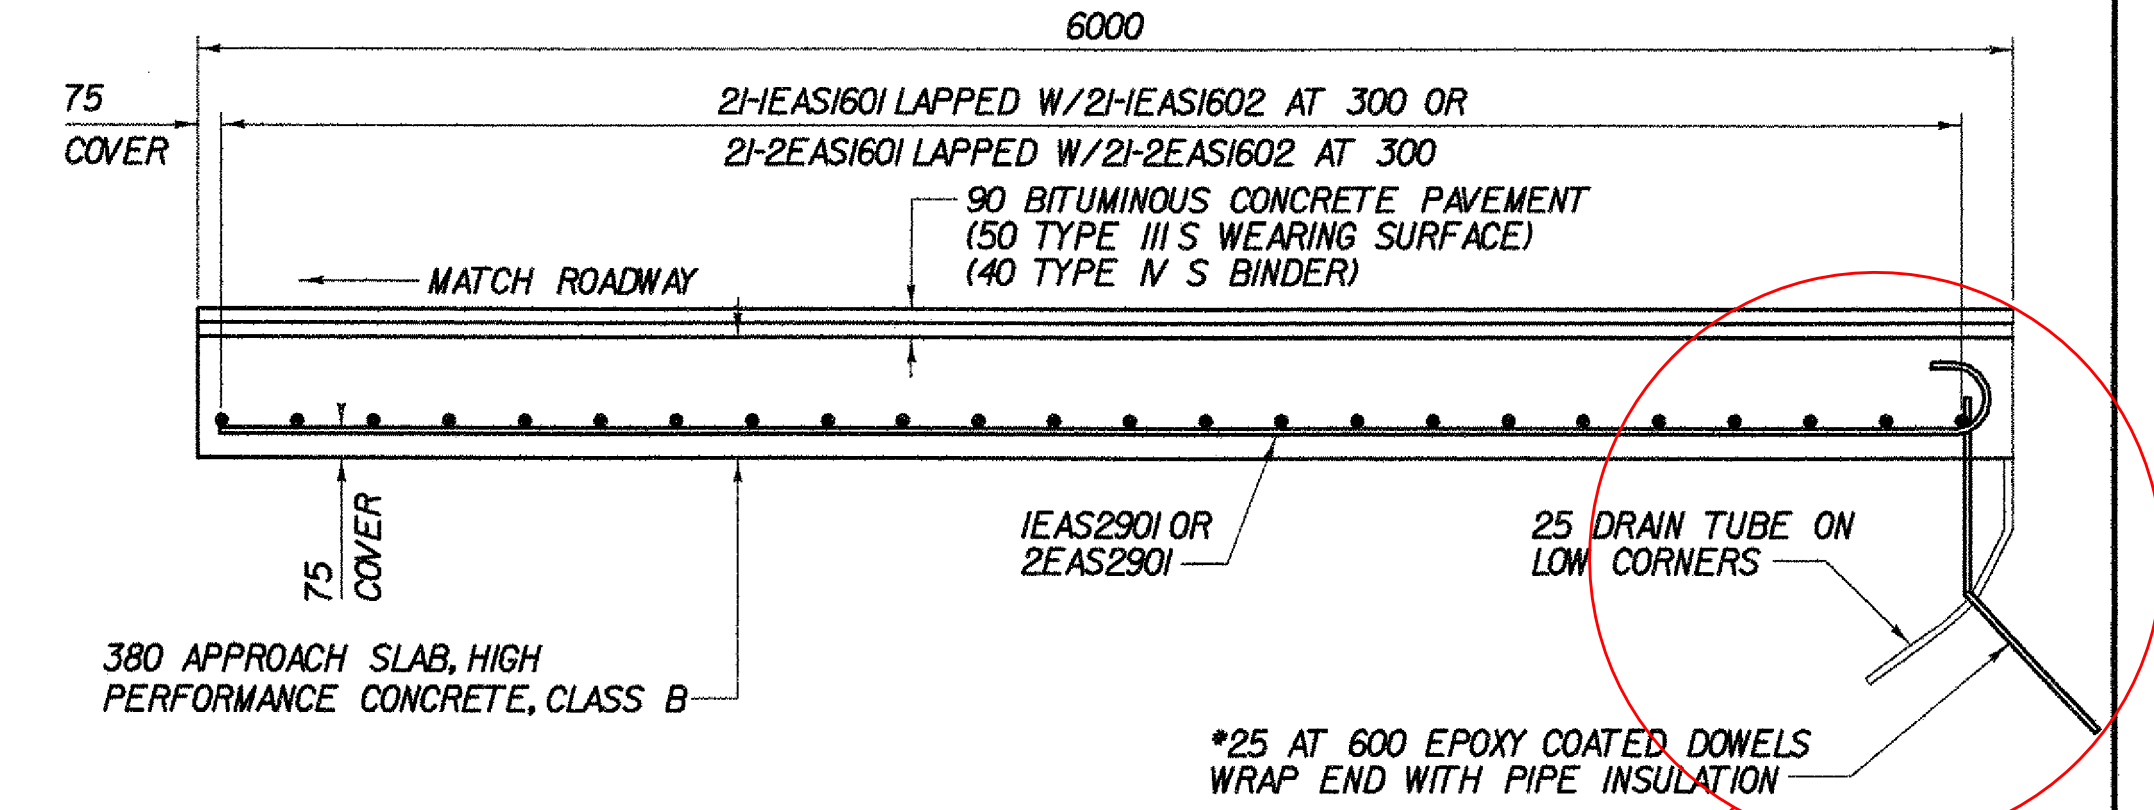



NOTES:

1. TIP HOOK END OF BAR AS REQUIRED TO ACHIEVE MINIMUM COVER.
2. FOR DETAILS OF APPROACH SLAB PAVEMENT AND TRANSITION TO EXISTING PAVEMENT, SEE ROADWAY PLANS.
3. FOR LIMIT OF EXCAVATION AND BACKFILL, SEE DETAILS ON PRELIMINARY INFORMATION SHEET BR501 AND THE HIGHWAY PLANS.

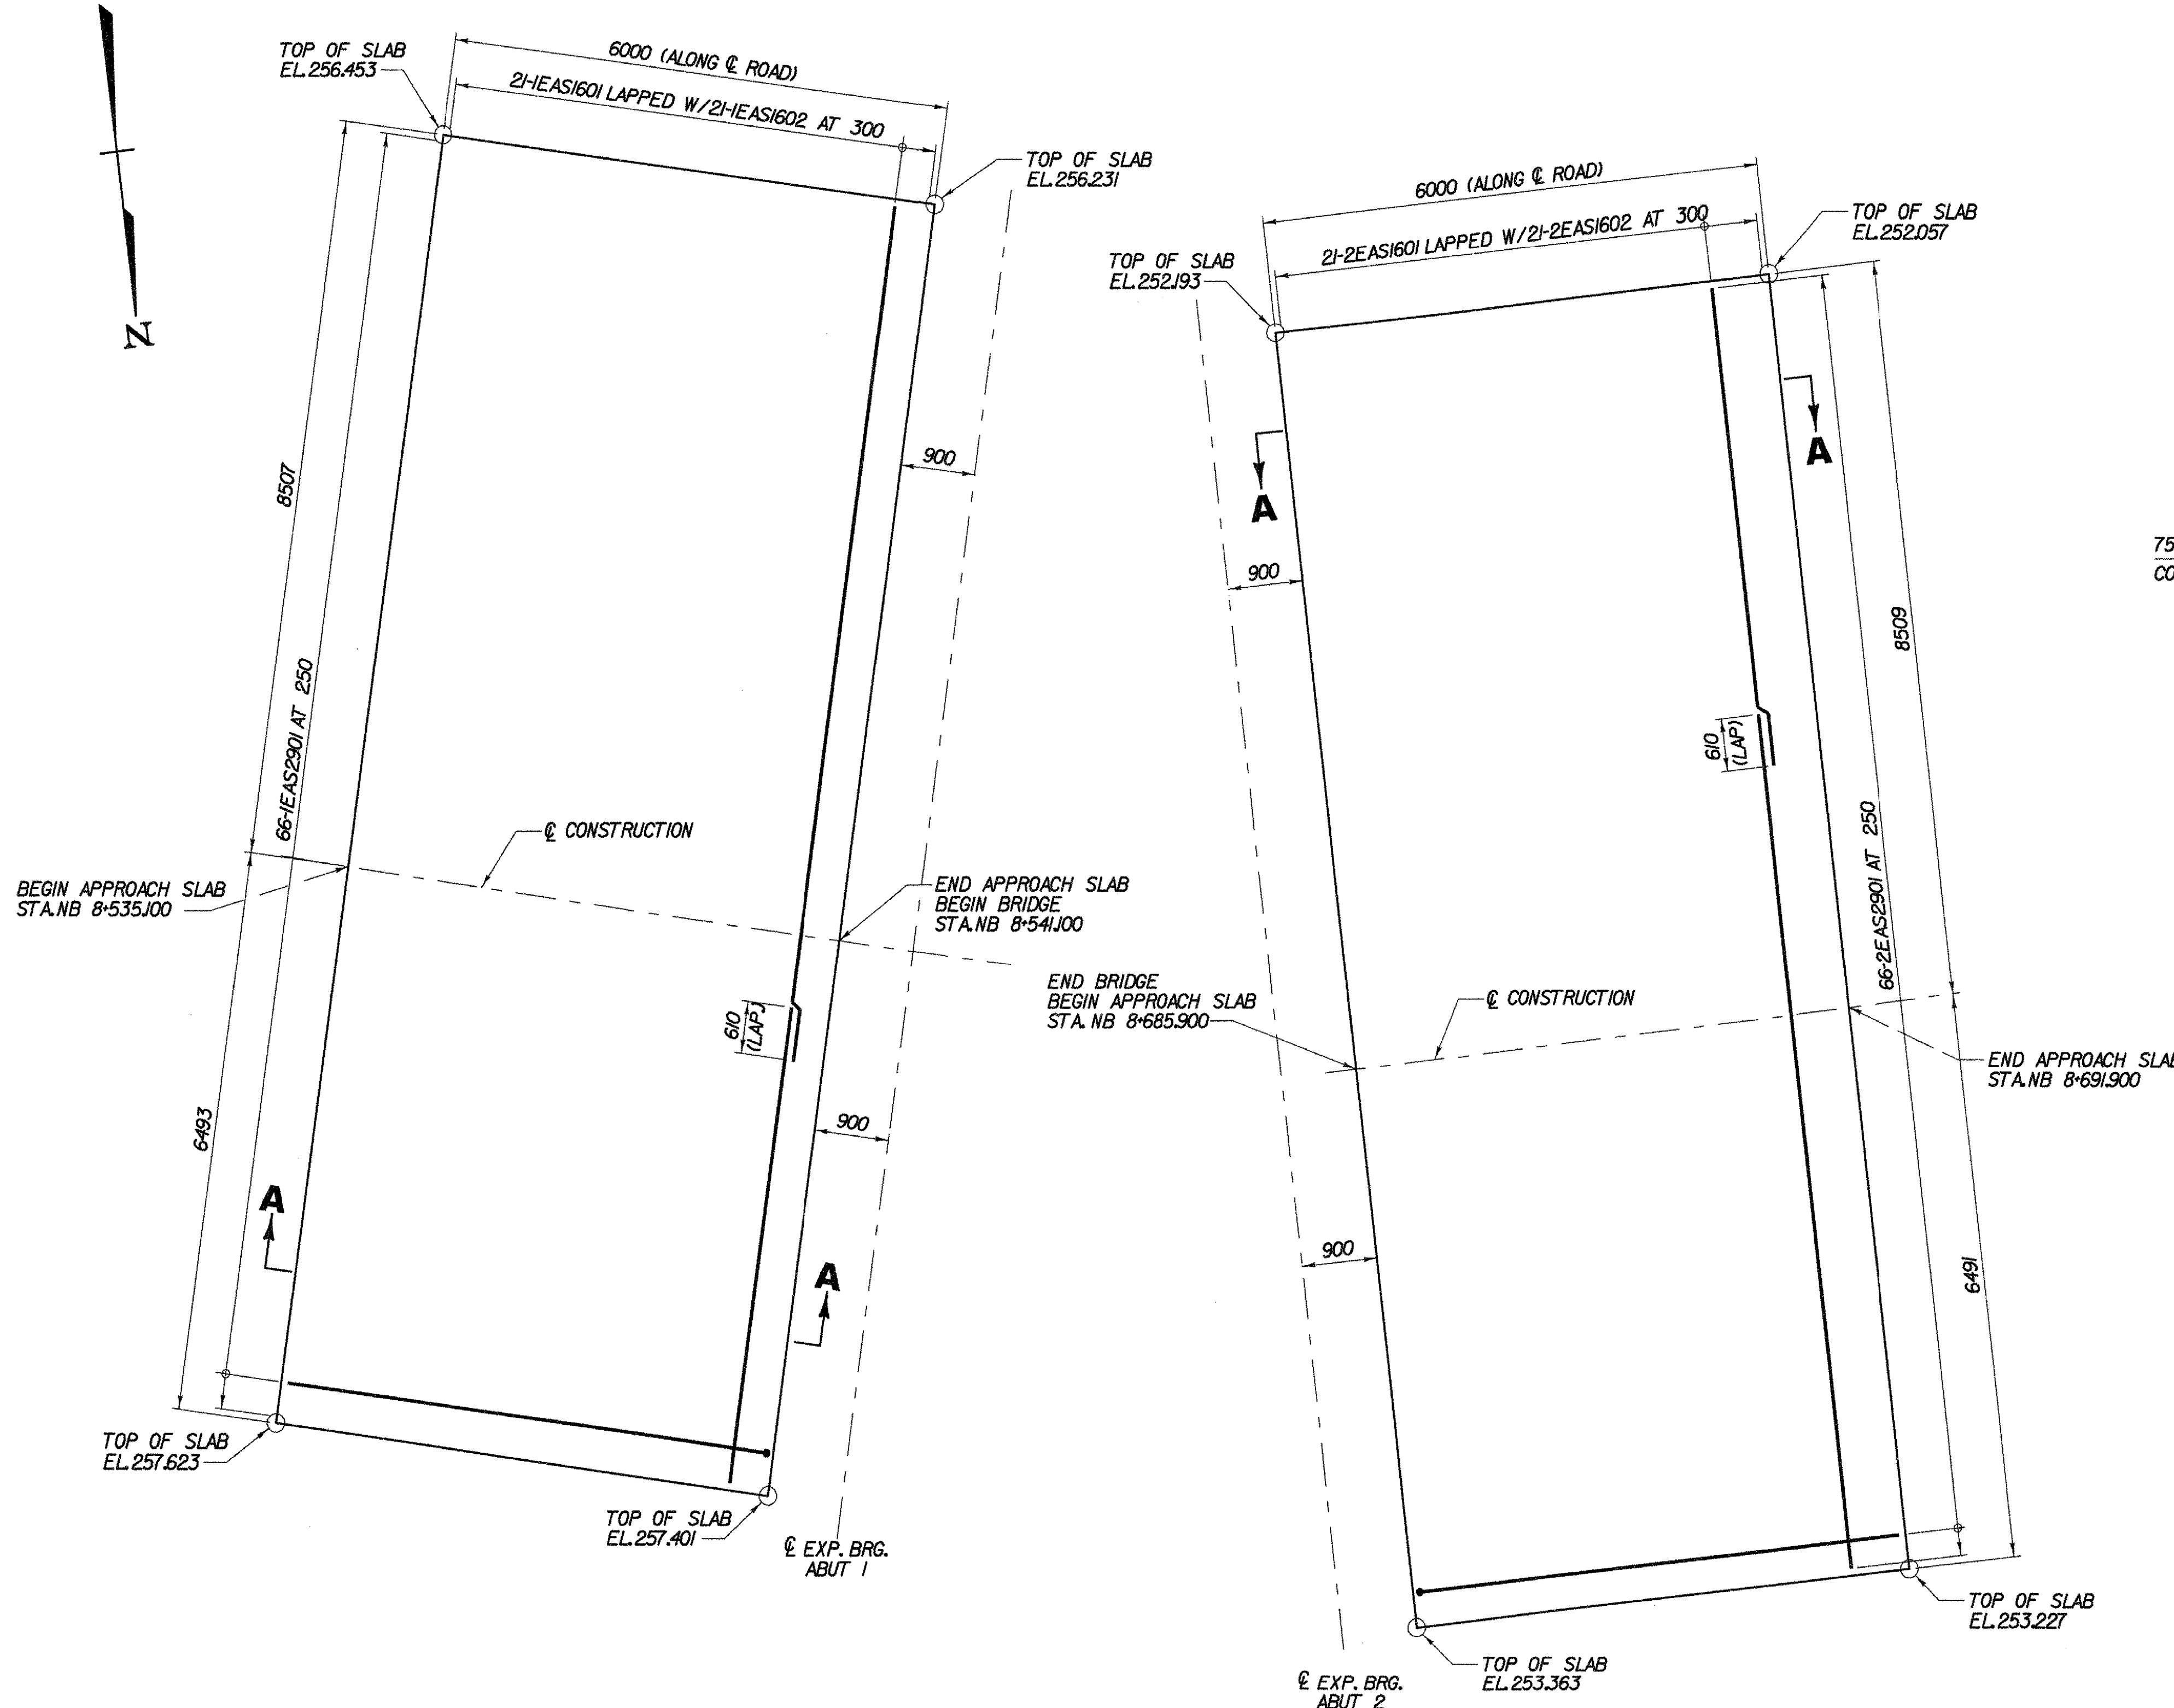

BRIDGE BEGIN APPROACH SLAB
SCALE 1:50

END BRIDGE APPROACH SLAB
SCALE 1:50

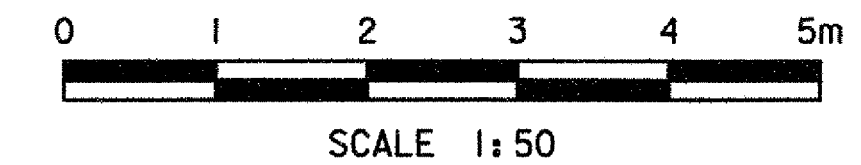

**STATE OF VERMONT
AGENCY OF TRANSPORTATION**

Town Of	BENNINGTON	Bridge No.	B12
Highway No.	VT RTE 279	Log Sta.	
		Surv. Sta.	
VT ROUTE 279 OVER FURNACE BROOK			
APPROACH SLAB LAYOUT AND DETAILS			
Designed By	J.J. MANUSE	Drawn By	D.J. HENDERSON
Checked By	Date	Bridge Design Supervisor	
B.J. CARLSON	04/07	K.M. WOJTKOWSKI	Date 04/07
PROJECT	BENNINGTON	PROJECT NO.	AC NH FO19-(53)
TVGA CAD Drawing No.	FBAppSlab.dgn	Date	04/10/2007
Bridge Sheet No.	BR529	Sheet	221 of 577

