



FOOTING REINFORCEMENT PLAN
SCALE 1:50

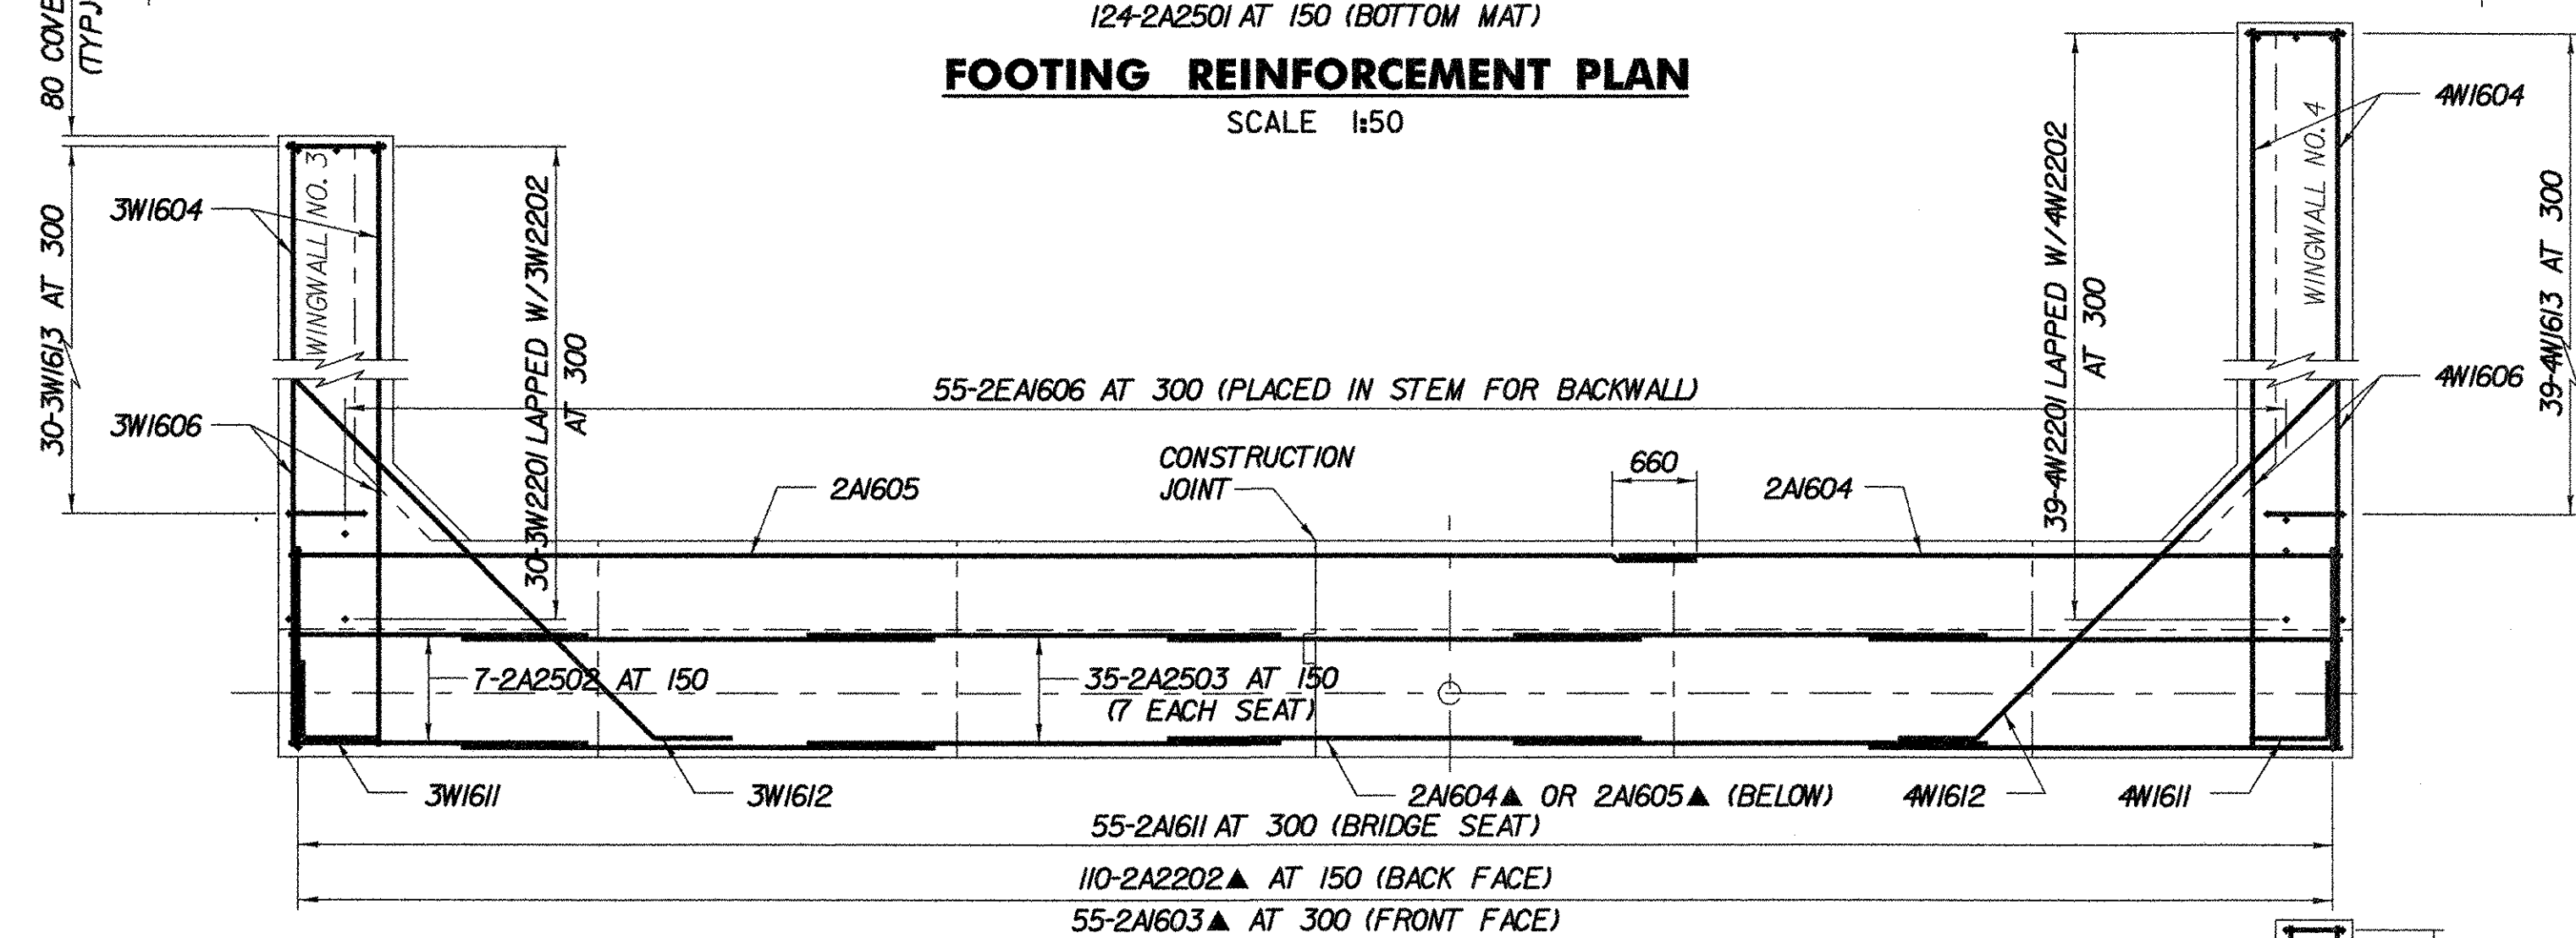

STEM REINFORCEMENT PLAN
SCALE 1:50

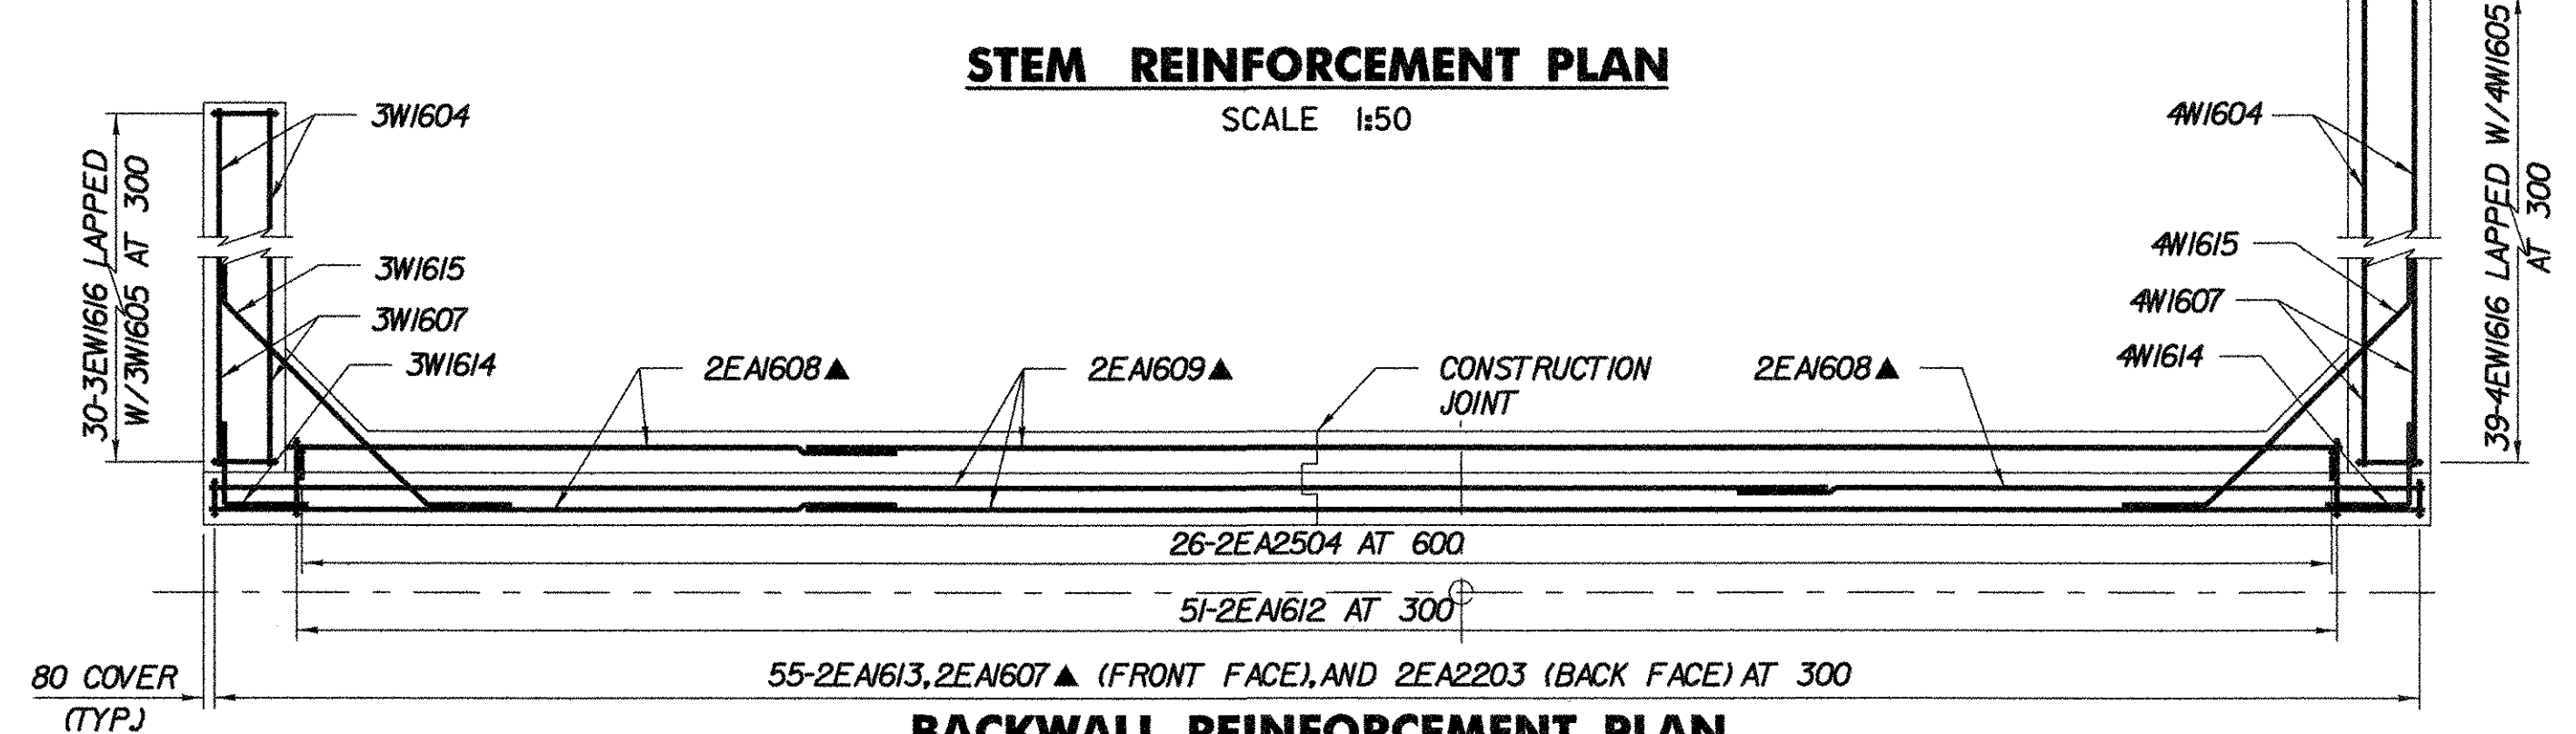

BACKWALL REINFORCEMENT PLAN
SCALE 1:50

LEGEND:
E.F. EACH FACE
▲ CUT TO FIT IN FIELD



STATE OF VERMONT AGENCY OF TRANSPORTATION	
Town Of BENNINGTON	Bridge No. B12
Highway No. VT RTE 279	Log Sta. Surv. Sta.
ABUTMENT 2 REINFORCEMENT PLANS	
Designed By M.D. BOWER	Drawn By D.S. URBINO
Checked By B.J. CARLSON	Date 04/07 Bridge Design Supervisor K.M. WOJTKOWSKI Date 04/07
PROJECT BENNINGTON	PROJECT NO. AC NH FO19-1(53)
TVGA CAD Drawing No. FBAbut2RebarLdgn	Date 04/16/2007
Bridge Sheet No. BR534	Sheet 226 of 577