



**LEGEND**

- PS - PROPOSED SEWER
- PW - PROPOSED WATER
- AERIAL E&T - PROPOSED OVERHEAD ELECTRIC & TELEPHONE
- AERIAL E&T - EXISTING OVERHEAD ELECTRIC & TELEPHONE

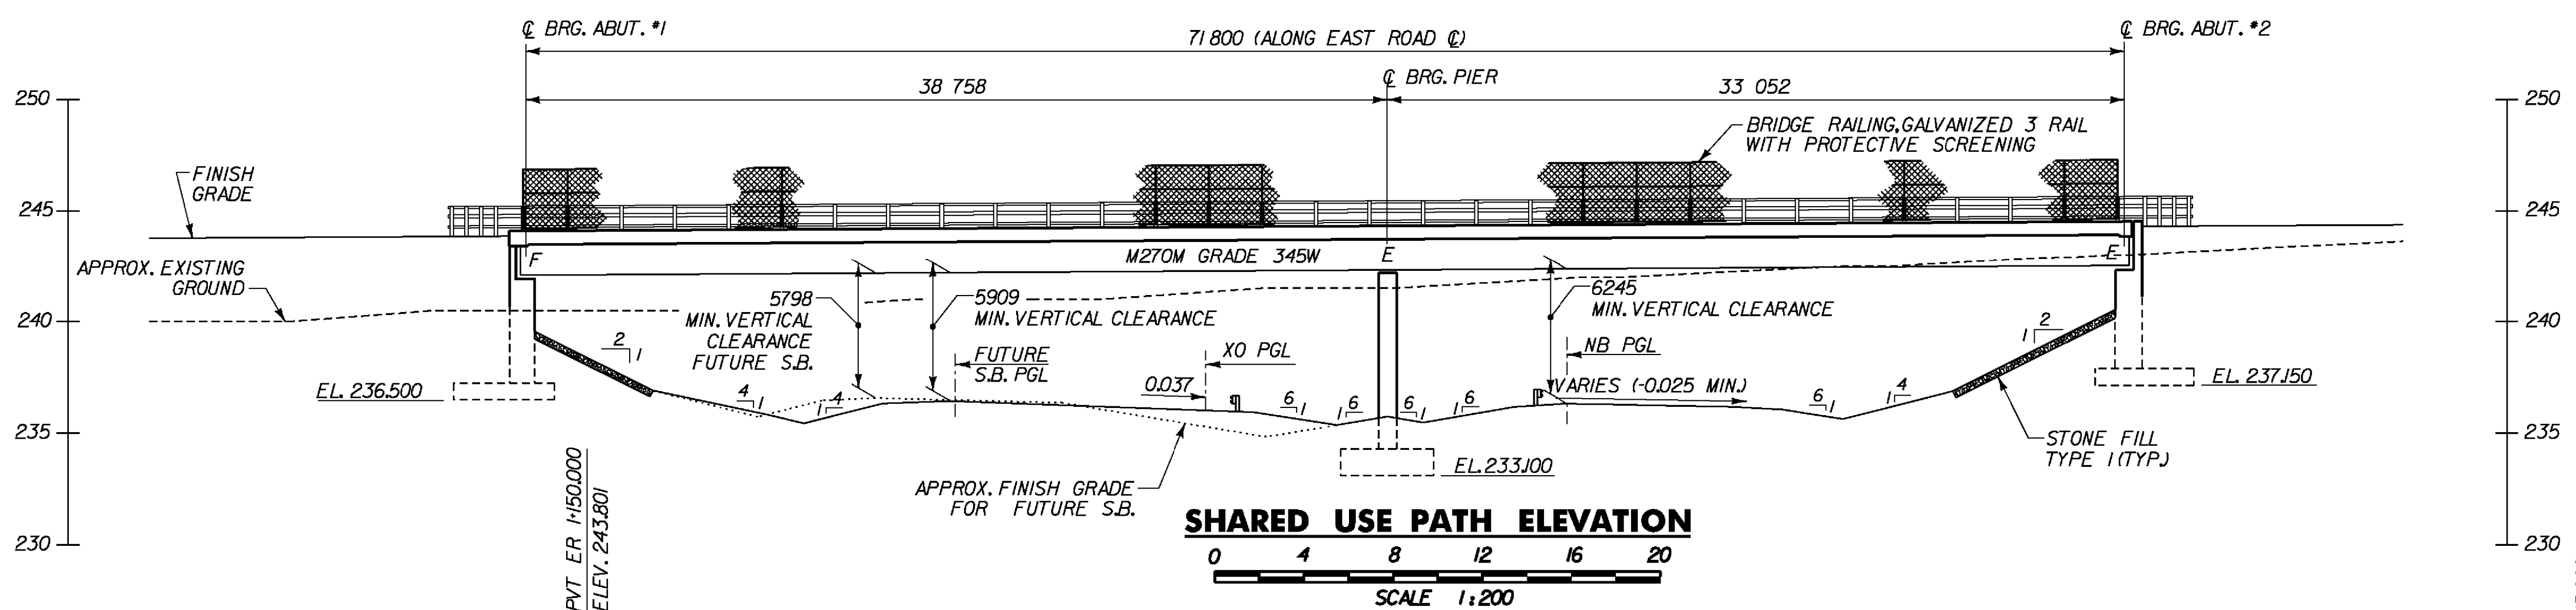

- NOTES:**
- SEE SHEET BR643 FOR PAY LIMITS OF BRIDGE RAIL AND RAIL POST LAYOUT.
  - REFER TO ROADWAY PLANS FOR TIE DATA.

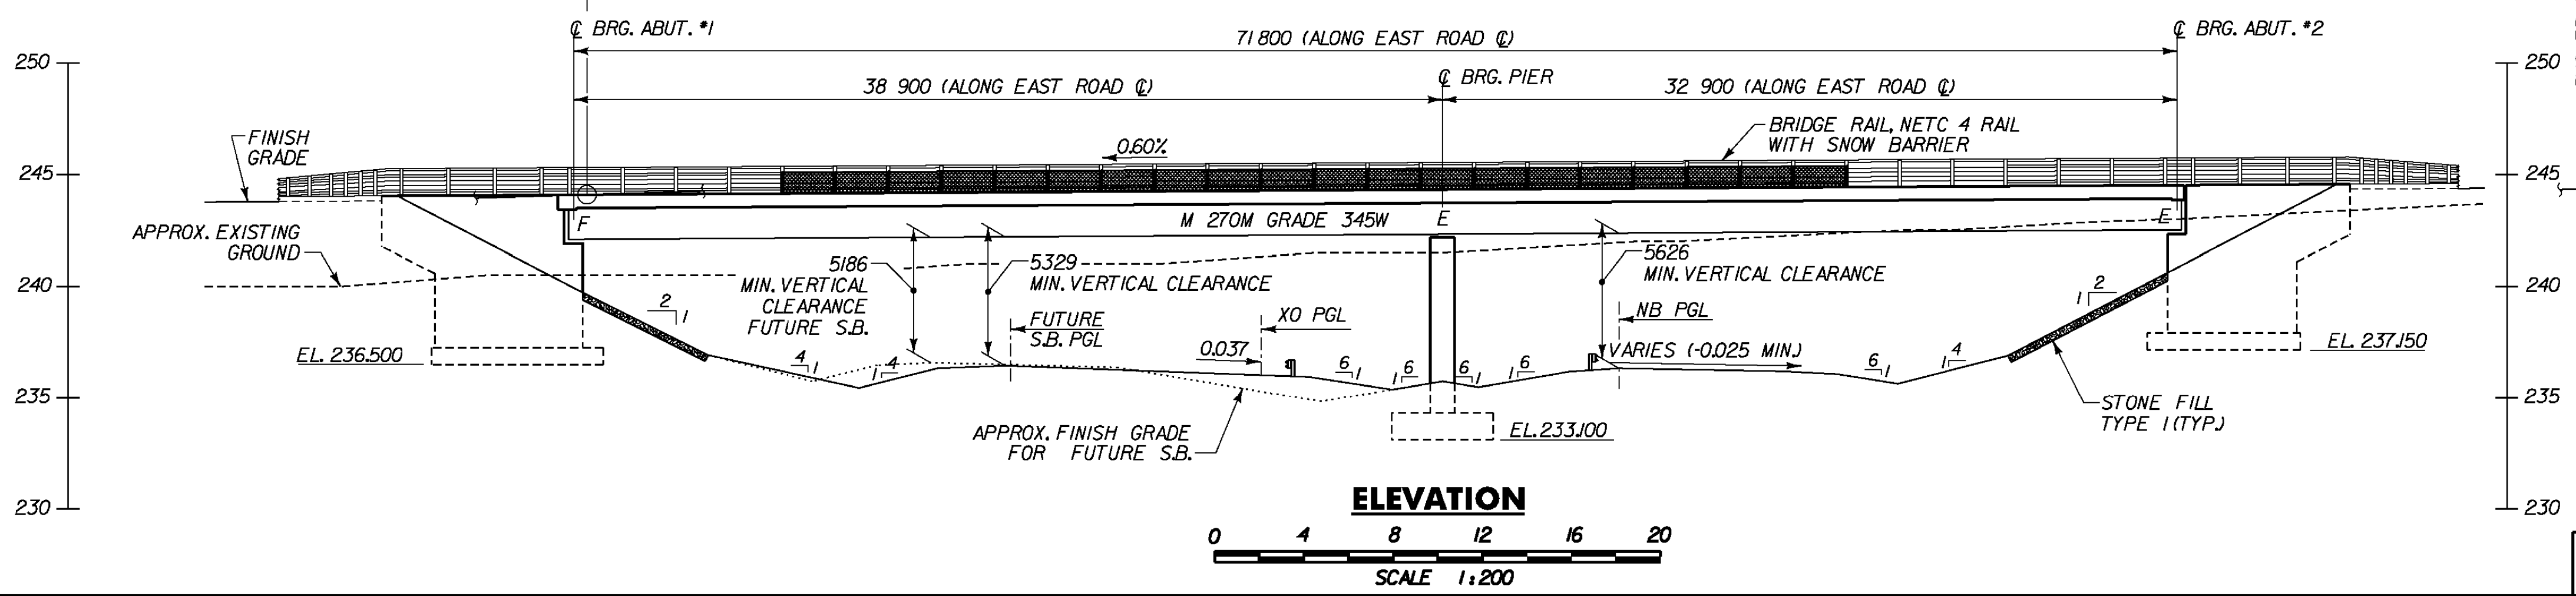

**STATE OF VERMONT  
AGENCY OF TRANSPORTATION**

Town Of	BENNINGTON	Bridge No.	Bill
Highway No.	TH 5	Log Sta.	
		Surv. Sta.	
<b>EAST ROAD OVER VT ROUTE 279</b>			
<b>PLAN AND ELEVATION</b>			
Designed By	T. KNIGHT	Drawn By	T. KNIGHT
Checked By	M. CHENETTE	Date	11/04
		Bridge Design Supervisor	G. BOGUE
		Date	03/07
PROJECT	BENNINGTON	PROJECT NO.	AC NH 019-(153)
Dgn.:	...Design\VER-Plan.dgn	Plot Date:	5/25/2011
Bridge Sheet No.	BR614	Sheet	261 of 577



V:\953\active\9530002\Transportation\Structural\Design\ER-Plan.dgn