
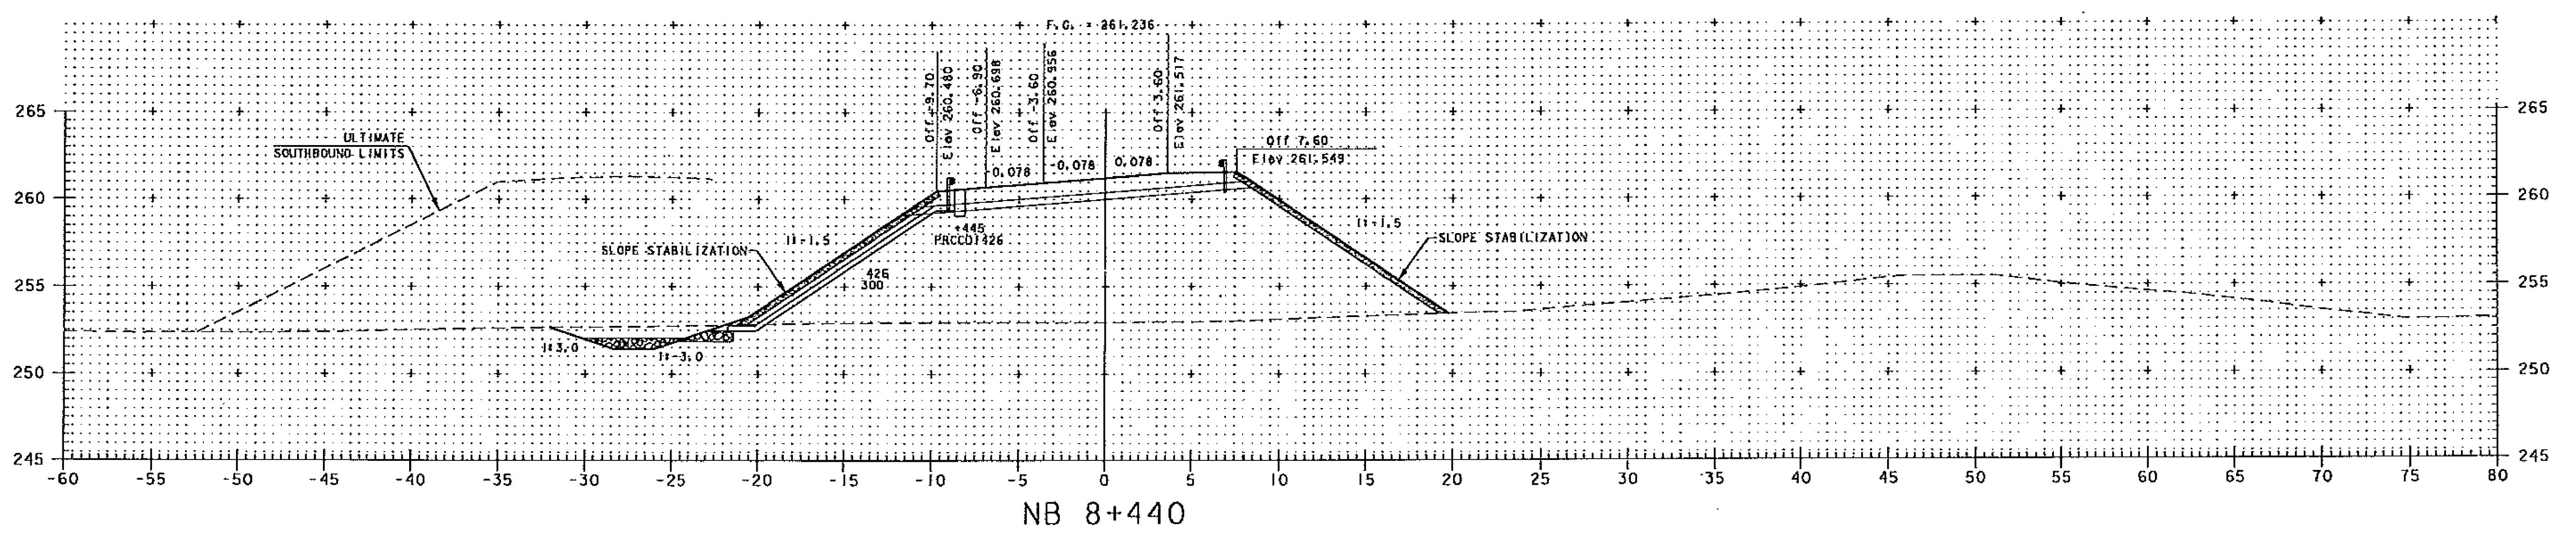



RECEIVED


JUN 17 2009

C.P.I.

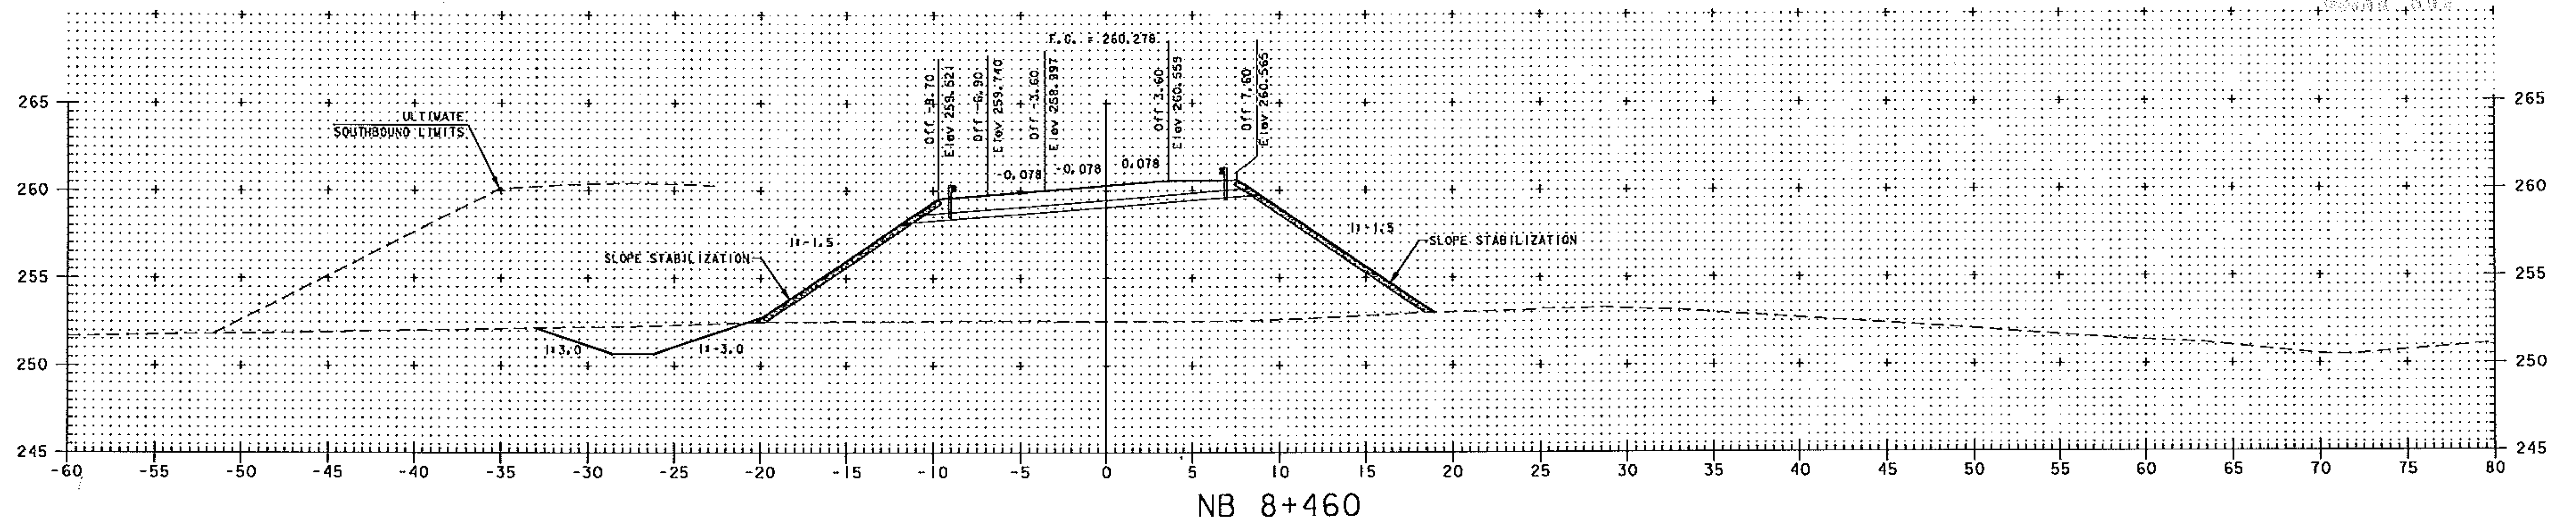

**NOTE:**  
ELEVATIONS SHOWN ARE FOR THE ULTIMATE FINISHED GRADE.  
THE TOP 50 PAVEMENT COURSE (TYPE IIIS) WILL BE CONSTRUCTED  
ON THE BRIDGE LIMITS. THIS CONTRACT INCLUDES FULL DEPTH  
PAVEMENT CONSTRUCTION ON BRIDGE LIMITS ONLY.

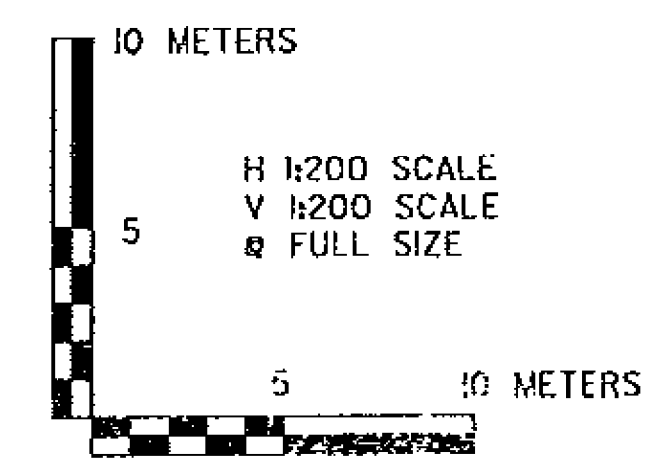

<b>VERMONT AGENCY OF TRANSPORTATION</b>	
 <b>Startec</b>	PROJECT NAME: BENNINGTON PROJECT NUMBER: AC NH 019-(K53)
	FILE NAME: ...vzd307c3.revised.ptf DESIGN SUPERVISOR: GREG EDWARDS DESIGNED BY: MARC FOISY <b>NB MAINLINE CROSS SECTIONS</b>

W:\952\ver\155\0002\transportation\drawing\contract\3\vertical\revision\vd307c3\_rv\secdp1.rvt