


RECORD PLANS

RECORDED


REVISED
4-3-2009



JUN 17 2009

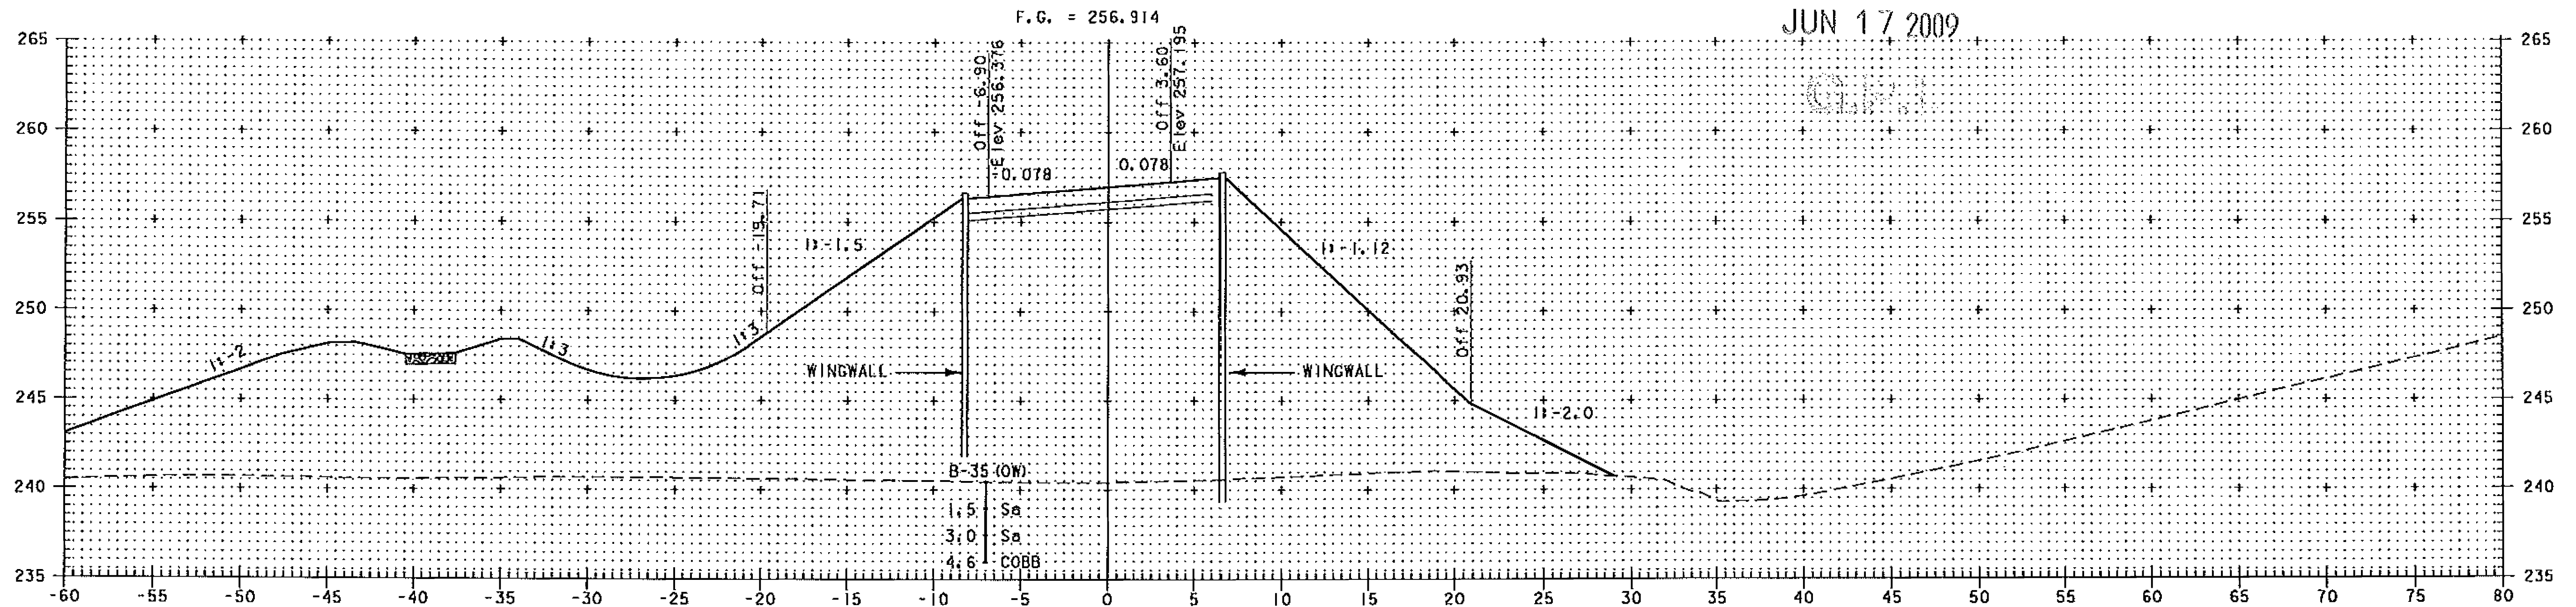


NB 8+540

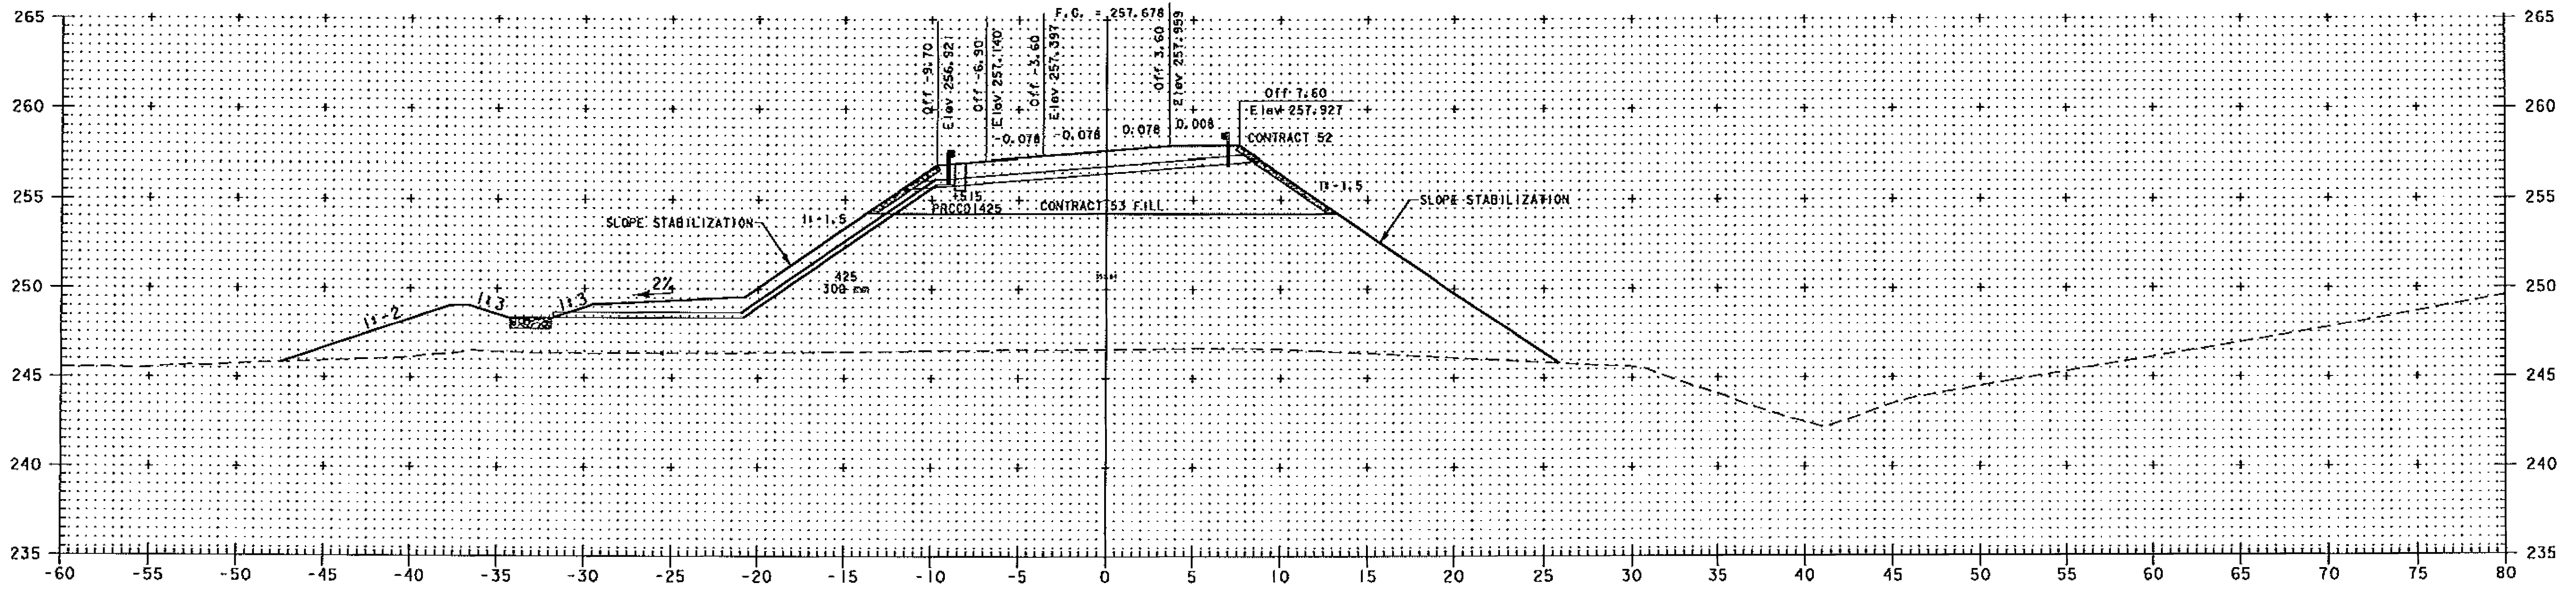

NB 8+520

NOTE:
ELEVATIONS SHOWN ARE FOR THE ULTIMATE FINISHED GRADE.
THE TOP 50 PAVEMENT COURSE (TYPE IIS) WILL BE CONSTRUCTED
ON THE BRIDGE LIMITS. THIS CONTRACT INCLUDES FULL DEPTH
PAVEMENT CONSTRUCTION ON BRIDGE LIMITS ONLY.

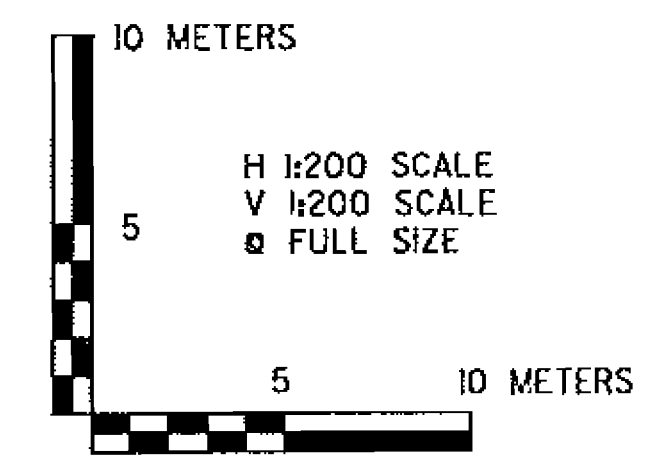

VERMONT AGENCY OF TRANSPORTATION

PROJECT NAME:	BENNINGTON	PLOT DATE:	6/16/2009
PROJECT NUMBER:	AC NH 019-1(53)	DRAWN BY:	STANTEC
FILE NAME:	...zd307c3.revised.ptf	CHECKED BY:	GARY SANTY
DESIGN SUPERVISOR:	GREG EDWARDS		
DESIGNED BY:	MARC FOISY		
NB MAINLINE CROSS SECTIONS		SHEET 299 OF 577	

V:\531\active\5310002\transportation\drawing\contract_3\vertical\revision\zd307c3_revised.dwg