
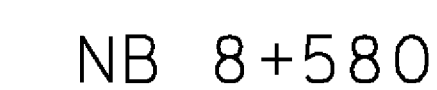


Metric

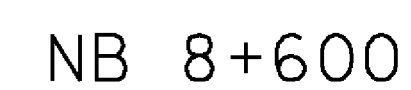

FILE NAME: ...\\zd307c3.revised.dgn
DESIGN SUPERVISOR: GREG EDWARDS
DESIGNED BY: MARC FOISY
NB MAINLINE CROSS SECTIONS 2

PLOT DATE: 4/10/2009
DRAWN BY: STANTEC
CHECKED BY: GARY SANTY
SHEET OF