



SUPERSEDED  
BY 2  
PREVIOUS  
SHEETS

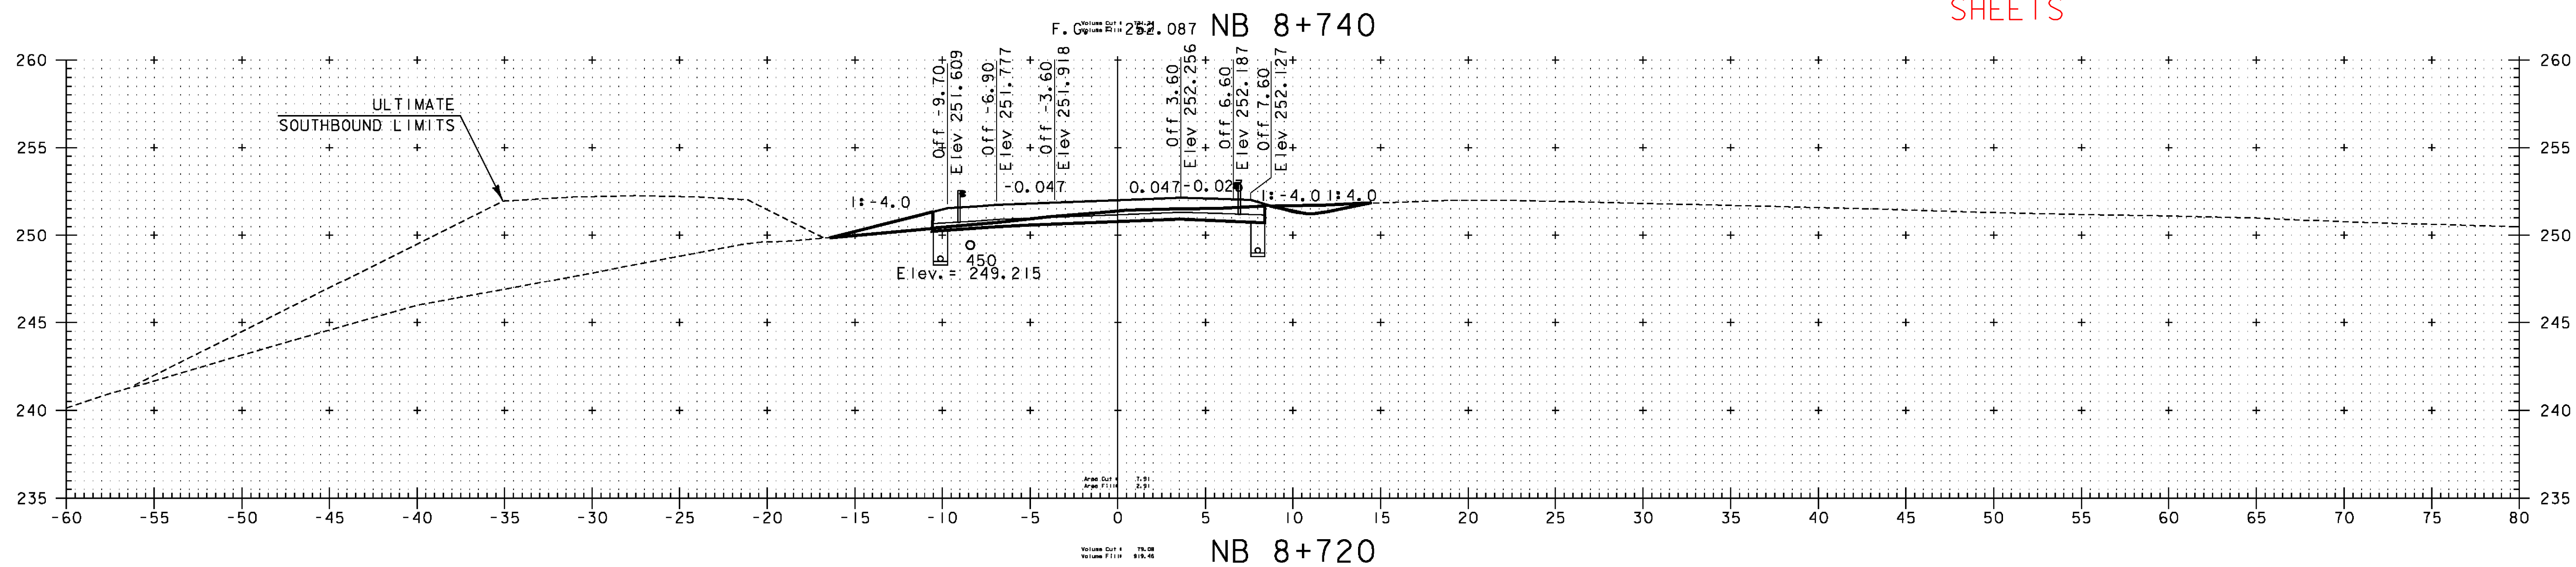

**NOTE:**  
**ElevATIONS SHOWN ARE FOR THE ULTIMATE FINISHED GRADE.**  
**THE TOP 50 PAVEMENT COURSE (TYPE IIIS) WILL NOT BE**  
**CONSTRUCTED AS PART OF THIS CONTRACT. THIS CONTRACT**  
**ONLY INCLUDES 100 OF TYPE IS AND 80 OF TYPE IIS**  
**SUPERPAVE BITUMINOUS CONCRETE PAVEMENT (ITEM 490.30).**  
**PLEASE REFER TO THE ROADWAY TYPICAL SECTIONS FOR DETAILS.**

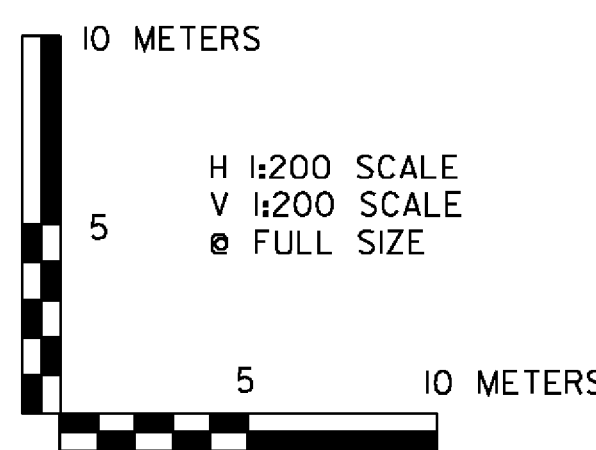

**VERMONT AGENCY OF TRANSPORTATION**



PROJECT NAME:	BENNINGTON	PLLOT DATE:	5/16/2011
PROJECT NUMBER:	AC NH 019-1(53)	DRAWN BY:	STANTEC
FILE NAME:	...\\plot_files\zd307c3xs_nb.p1f	DESIGNED BY:	MARC FOISY
DESIGN SUPERVISOR:	GREG EDWARDS	CHECKED BY:	GARY SANTY
<b>NB MAINLINE CROSS SECTIONS</b>		SHEET 304 OF 577	