



REVISED
4-3-2009

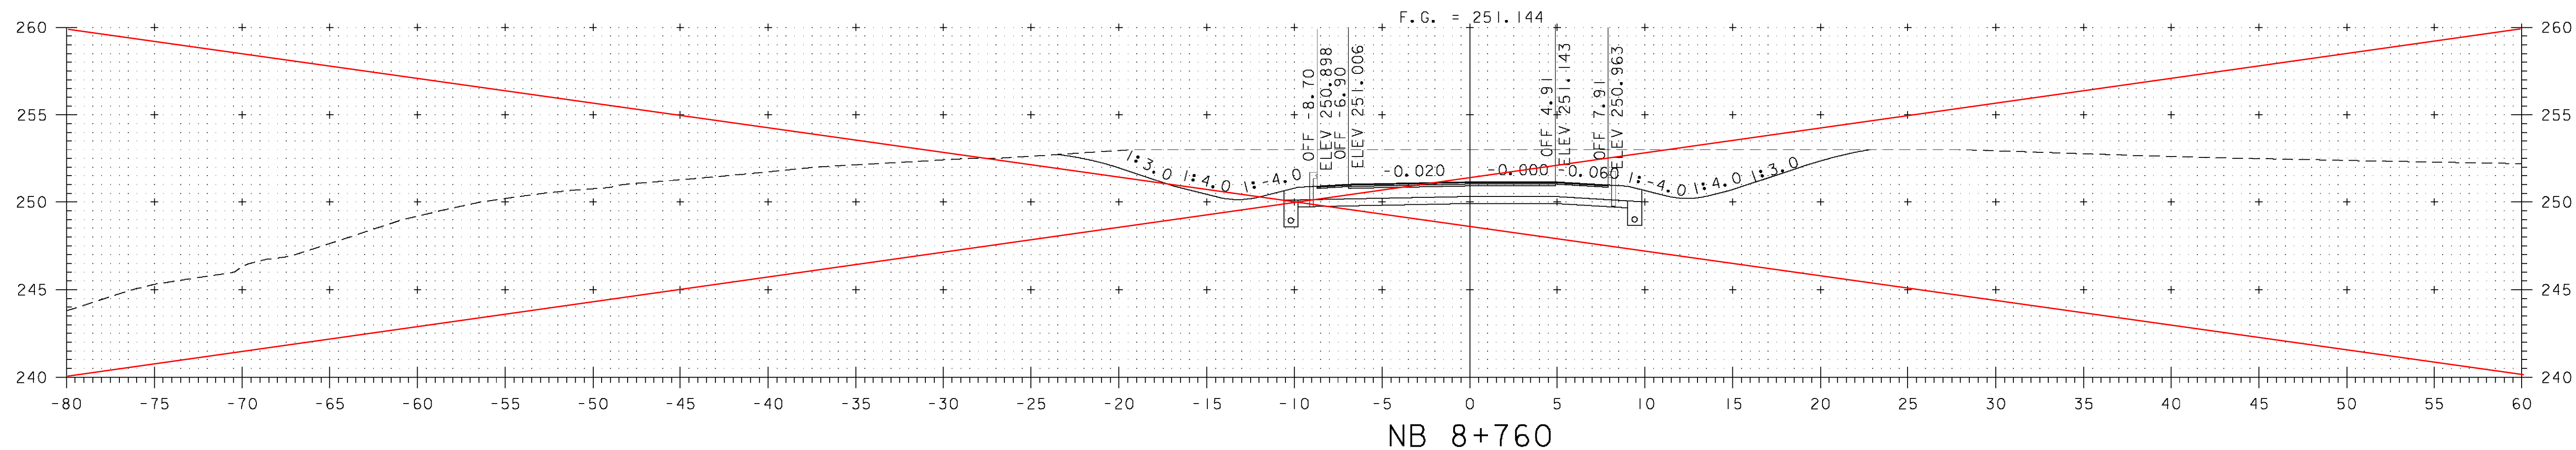


NB 8+760

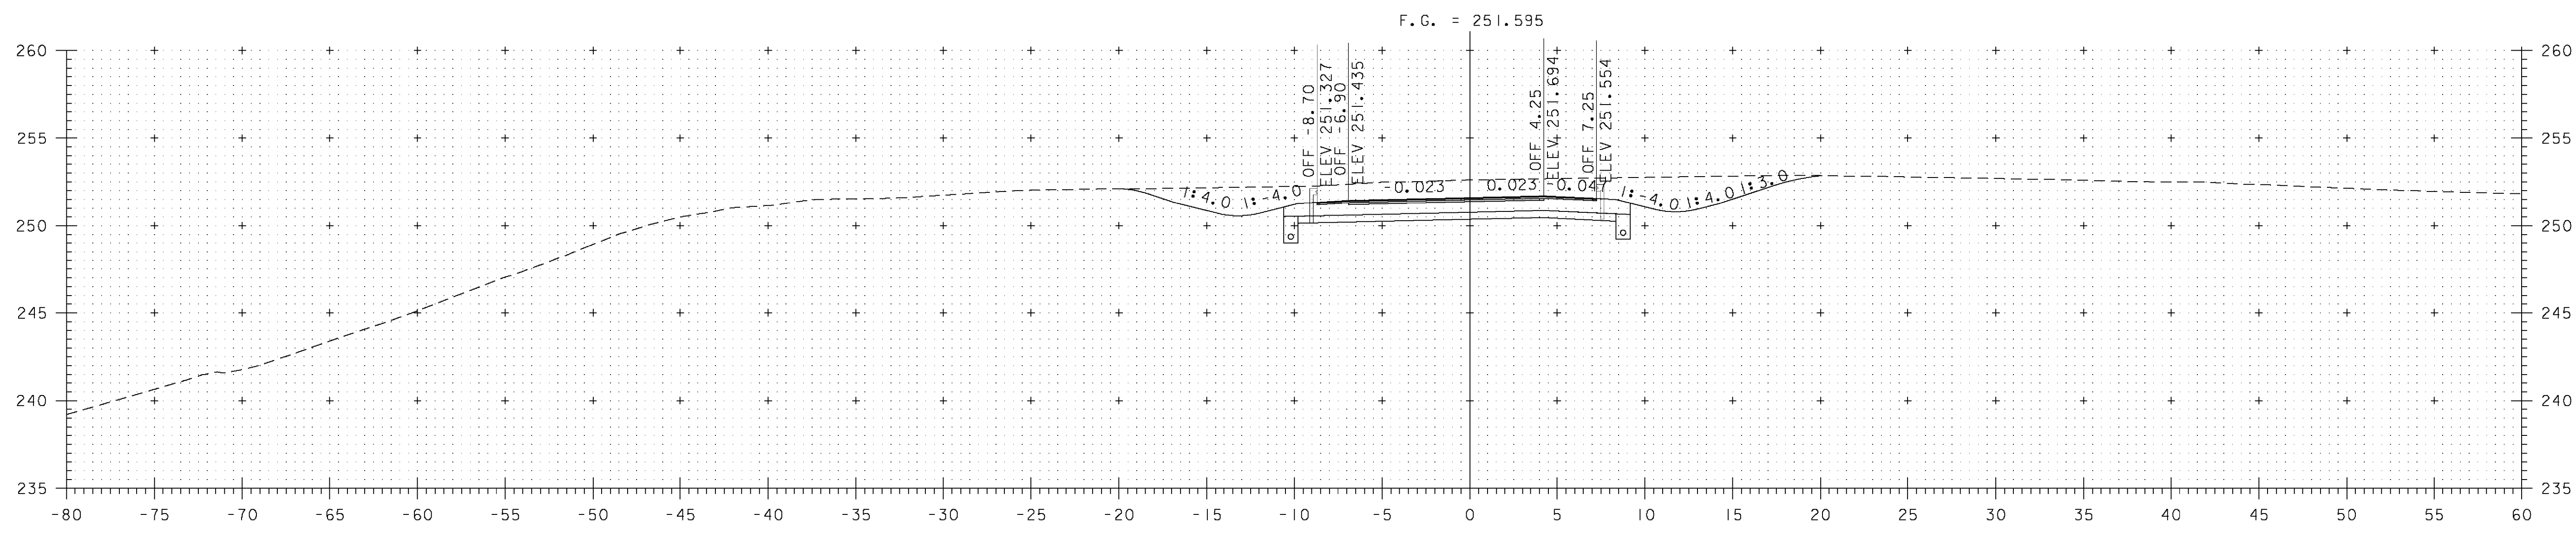

NB 8+740

NOTE:
ELEVATIONS SHOWN ARE FOR THE ULTIMATE FINISHED GRADE.
THE TOP 50 PAVEMENT COURSE (TYPE IIIS) WILL BE CONSTRUCTED
ON THE BRIDGE LIMITS. THIS CONTRACT INCLUDES FULL DEPTH
PAVEMENT CONSTRUCTION ON BRIDGE LIMITS ONLY.

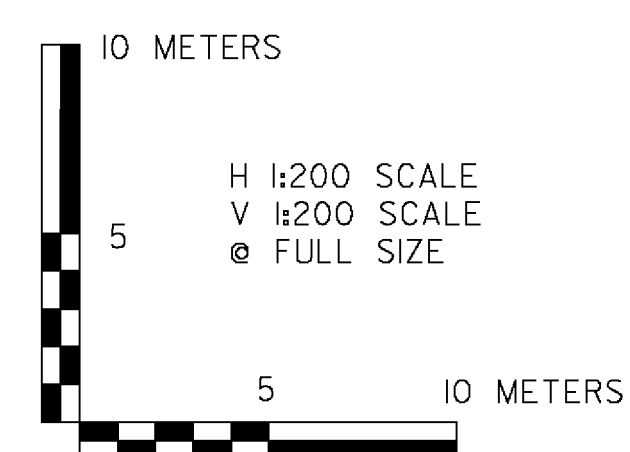

| | |
|---|---------------------------------|
| VERMONT AGENCY OF TRANSPORTATION | |
| | PROJECT NAME: BENNINGTON |
| | PROJECT NUMBER: AC NH 019-1(53) |
| FILE NAME: ...\\zd307c3.revised.dgn | PLOT DATE: 4/10/2009 |
| DESIGN SUPERVISOR: GREG EDWARDS | DRAWN BY: STANTEC |
| DESIGNED BY: MARC FOISY | CHECKED BY: GARY SANTY |
| NB MAINLINE CROSS SECTIONS 6 | SHEET OF |

V:\1953\active\1953\0002\1\cns\pav\mainline\cross\sect_3\Ver-Final\Revision\zd307c3.r.revised.dgn