


SUPERSEDED  
BY  
PRECEDING  
SHEET

**NOTE:**  
**ElevATIONS SHOWN ARE FOR THE ULTIMATE FINISHED GRADE.**  
**THE TOP 50 PAVEMENT COURSE (TYPE IIIS) WILL NOT BE**  
**CONSTRUCTED AS PART OF THIS CONTRACT. THIS CONTRACT**  
**ONLY INCLUDES 100 OF TYPE IIS AND 80 OF TYPE IIS**  
**SUPERPAVE BITUMINOUS CONCRETE PAVEMENT (ITEM 490.30).**  
**PLEASE REFER TO THE ROADWAY TYPICAL SECTIONS FOR DETAILS.**



**VERMONT AGENCY OF TRANSPORTATION**

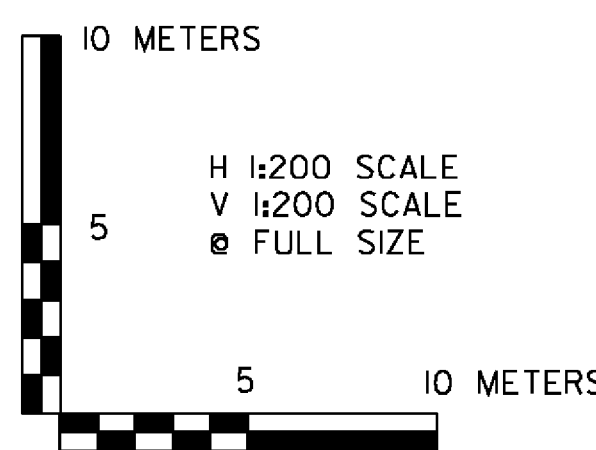

PROJECT NAME: BENNINGTON	PLOT DATE: 5/16/2011
PROJECT NUMBER: AC NH 019-1(53)	DRAWN BY: STANTEC
FILE NAME: ...\\plot_files\zd307c3xs_nb.p1f	CHECKED BY: GARY SANTY
DESIGN SUPERVISOR: GREG EDWARDS	SHEET 307 OF 577
DESIGNED BY: MARC FOISY	
<b>NB MAINLINE CROSS SECTIONS</b>	

w:\953\active\9530002\transportation\drawing\contract\_3\plot\_files\zd307c3xs\_nb.p1f