



NOTE:
 ELEVATIONS SHOWN ARE FOR THE ULTIMATE FINISHED GRADE.
 THE TOP 50 PAVEMENT COURSE (TYPE IIIS) WILL BE CONSTRUCTED
 ON THE BRIDGE LIMITS. THIS CONTRACT INCLUDES FULL DEPTH
 PAVEMENT CONSTRUCTION ON BRIDGE LIMITS ONLY.



VERMONT AGENCY OF TRANSPORTATION

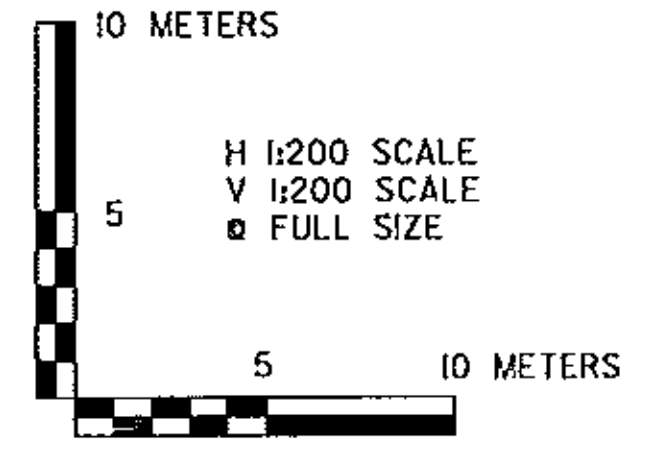

PROJECT NAME: BENNINGTON	PLOT DATE: 6/16/2009
PROJECT NUMBER: AC NH 019-(K53)	DRAWN BY: STANTEC
FILE NAME: ...vd307c3.rev1sed.ptf	CHECKED BY: GARY SANTY
DESIGN SUPERVISOR: GREG EDWARDS	SHEET 307 OF 577
DESIGNED BY: MARC FOISY	
NB MAINLINE CROSS SECTIONS	

V:\953\active\953\0002\transportation\drawing\contract\3\Var\1001\Revision\vd307c3.rev1sed.ptf