


SUPERSEDED
BY
PRECEDING
SHEET

NOTE:
 Elevations shown are for the ultimate finished grade. The top 50 pavement course (type IIIS) will not be constructed as part of this contract. This contract only includes 100 of type IS and 80 of type IIS superpave bituminous concrete pavement (item 490.30). Please refer to the roadway typical sections for details.



VERMONT AGENCY OF TRANSPORTATION

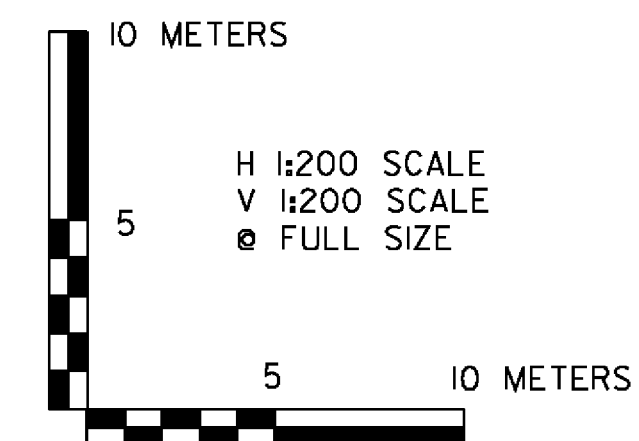

PROJECT NAME: BENNINGTON
 PROJECT NUMBER: AC NH 019-1(53)

FILE NAME: ...plot_files\zd307c3xs_nb.pft PLOT DATE: 5/16/2011
 DESIGN SUPERVISOR: GREG EDWARDS DRAWN BY: STANTEC
 DESIGNED BY: MARC FOISY CHECKED BY: GARY SANTY
 NB MAINLINE CROSS SECTIONS SHEET 311 OF 577