


**NOTE:**  
 ELEVATIONS SHOWN ARE FOR THE ULTIMATE FINISHED GRADE.  
 THE TOP 50 PAVEMENT COURSE (TYPE IIIS) WILL BE CONSTRUCTED  
 ON THE BRIDGE LIMITS. THIS CONTRACT INCLUDES FULL DEPTH  
 PAVEMENT CONSTRUCTION ON BRIDGE LIMITS ONLY.

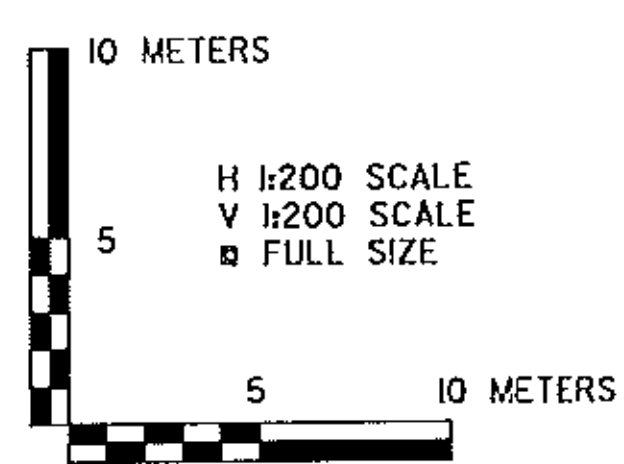

VERMONT AGENCY OF TRANSPORTATION

PROJECT NAME: BENNINGTON	PLOT DATE: 6/16/2009
PROJECT NUMBER: AC NH 019-K53)	DRAWN BY: STANTEC
FILE NAME: ...zd307c3.revised.prf	CHECKED BY: GARY SANTY
DESIGN SUPERVISOR: GREG EDWARDS	SHEET 312 OF 577
DESIGNED BY: MARC FOISY	
<b>NB MAINLINE CROSS SECTIONS</b>	

I:\US3\active\19530002\Transportation\rev\9+040\9+040.dwg