


SUPERSEDED  
BY  
PRECEDING  
SHEET

**NOTE:**  
 Elevations shown are for the ultimate finished grade. THE TOP 50 PAVEMENT COURSE (TYPE IIIS) WILL NOT BE CONSTRUCTED AS PART OF THIS CONTRACT. THIS CONTRACT ONLY INCLUDES 100' OF TYPE IS AND 80' OF TYPE IIS SUPERPAVE BITUMINOUS CONCRETE PAVEMENT (ITEM 490.30). PLEASE REFER TO THE ROADWAY TYPICAL SECTIONS FOR DETAILS.



VERMONT AGENCY OF TRANSPORTATION

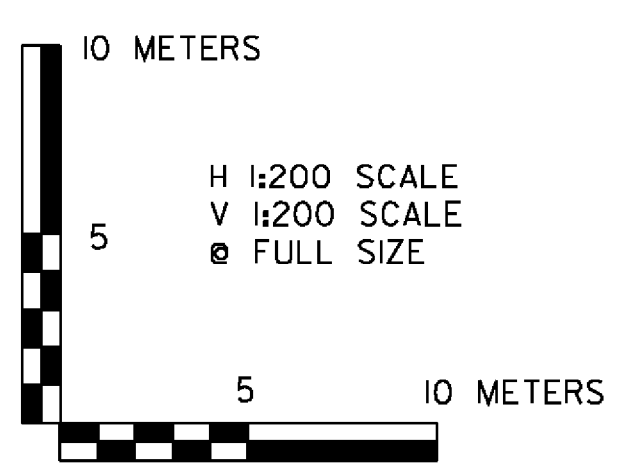

PROJECT NAME:	BENNINGTON	FILE NAME:	...\\plot_files\zd307c3xs_nb.pxf	PLOT DATE:	5/16/2011
PROJECT NUMBER:	AC NH 019-1(53)	DESIGN SUPERVISOR:	GREG EDWARDS	DRAWN BY:	STANTEC
		DESIGNED BY:	MARC FOISY	CHECKED BY:	GARY SANTY
<b>NB MAINLINE CROSS SECTIONS</b>			SHEET 313 OF 577		

w:\953\active\9530002\transportation\drawing\contract\_3\plot\_files\zd307c3xs\_nb.pxf