
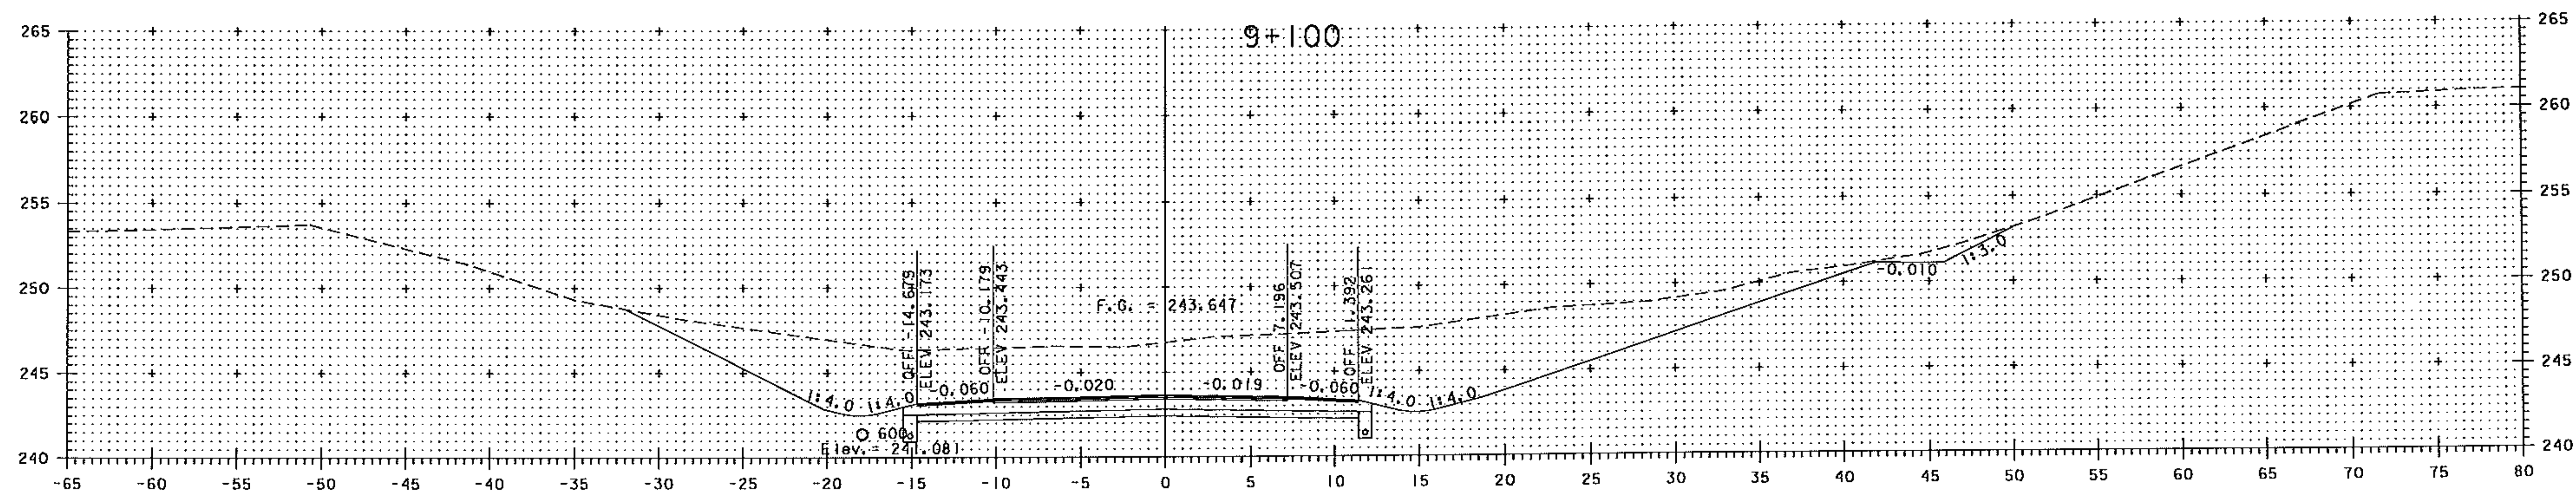



JUN 17 2009 RECORD PLANS

G.P.I.

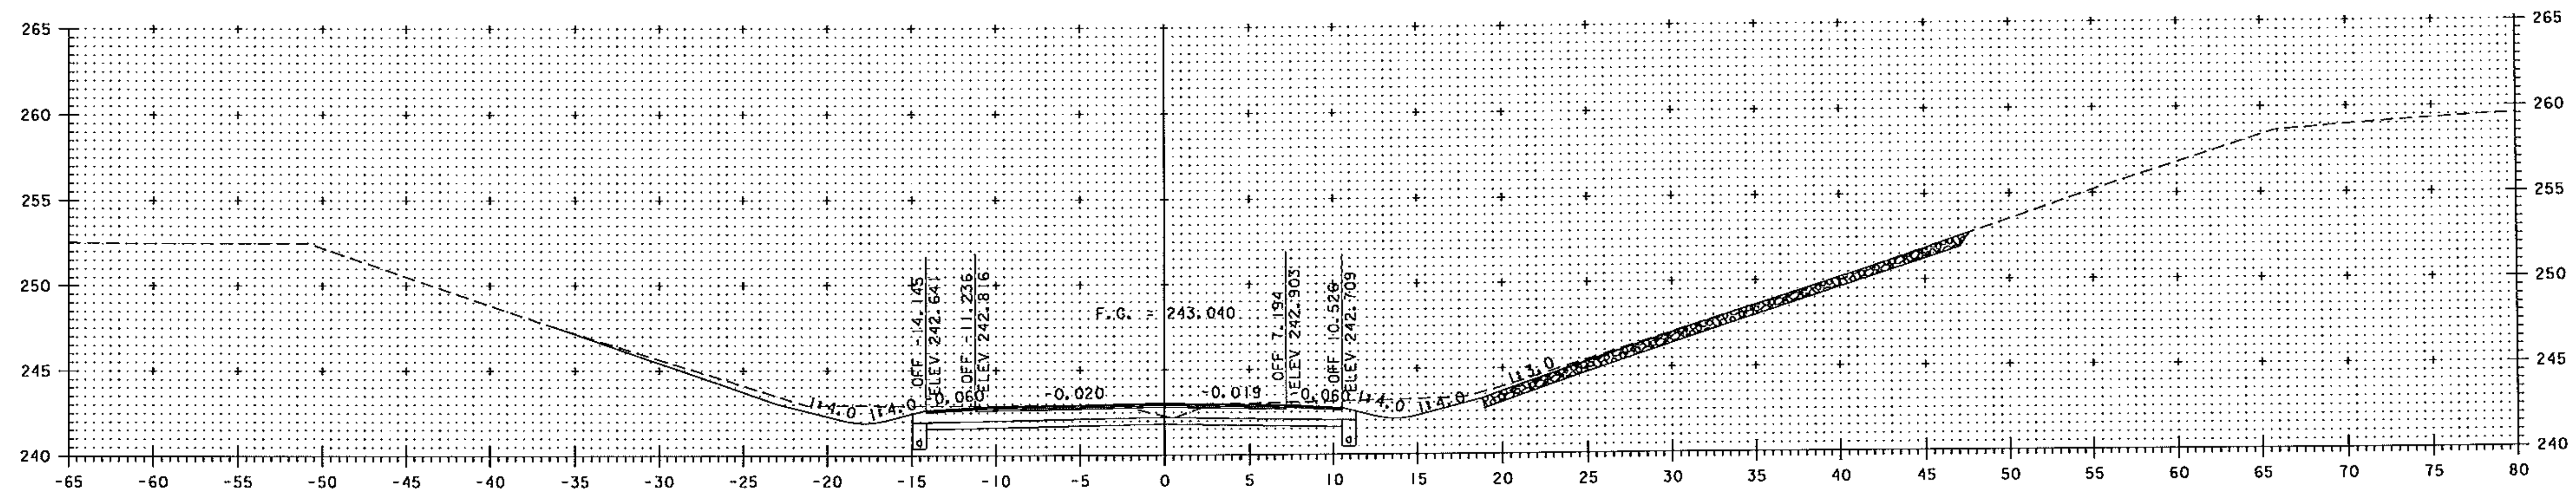

9+080

NOTE:
 ELEVATIONS SHOWN ARE FOR THE ULTIMATE FINISHED GRADE.
 THE TOP 50 PAVEMENT COURSE (TYPE IIIS) WILL BE CONSTRUCTED
 ON THE BRIDGE LIMITS. THIS CONTRACT INCLUDES FULL DEPTH
 PAVEMENT CONSTRUCTION ON BRIDGE LIMITS ONLY.

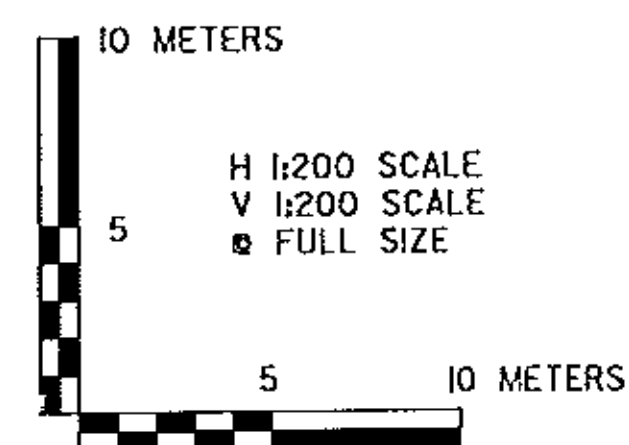

VERMONT AGENCY OF TRANSPORTATION



PROJECT NAME: BENNINGTON
 PROJECT NUMBER: AC NH 019-K(53)

FILE NAME: ...zd307c3.revised.prf
 DESIGN SUPERVISOR: GREG EDWARDS
 DESIGNED BY: MARC FOISY
 NB MAINLINE CROSS SECTIONS

PLOT DATE: 6/16/2009
 DRAWN BY: STANTEC
 CHECKED BY: GARY SANTY
 SHEET 313 OF 577