


NOTE:
ELEVATIONS SHOWN ARE FOR THE ULTIMATE FINISHED GRADE. THE TOP 50 PAVEMENT COURSE (TYPE IIIS) WILL NOT BE CONSTRUCTED AS PART OF THIS CONTRACT. THIS CONTRACT ONLY INCLUDES 100 OF TYPE IS AND 80 OF TYPE IIS SUPERPAVE BITUMINOUS CONCRETE PAVEMENT (ITEM 490.30). PLEASE REFER TO THE ROADWAY TYPICAL SECTIONS FOR DETAILS.

NOTE:
ALL OFFSETS ARE FROM NORTHBOUND ALIGNMENT
SECTIONS CUT PERPENDICULAR TO NORTHBOUND ALIGNMENT
THEREFORE THE CROSSOVER IS SKEWED



VERMONT AGENCY OF TRANSPORTATION

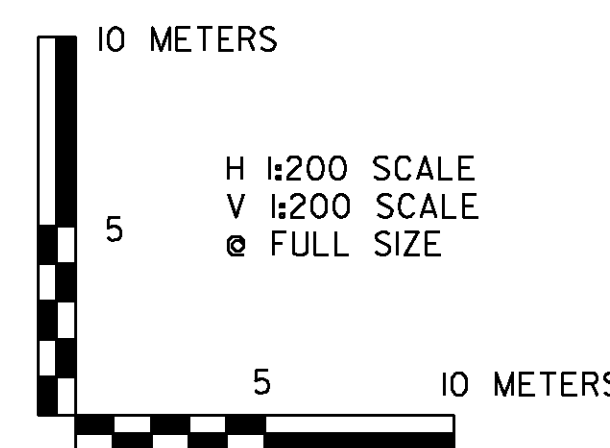

PROJECT NAME:	BENNINGTON
PROJECT NUMBER:	AC NH 019-(153)
FILE NAME:	...\\plot_files\zd307c3xs_nbxo.pxf
DESIGN SUPERVISOR:	GREG EDWARDS
DESIGNED BY:	MARC FOISY
PLOT DATE:	11/11/2011
DRAWN BY:	STANTEC
CHECKED BY:	GARY SANTY
NB MAINLINE CROSS SECTIONS	
SHEET 316 OF 577	