


SUPERSEDED  
BY  
PRECEDING  
SHEET

**NOTE:**  
**ElevATIONS SHOWN ARE FOR THE ULTIMATE FINISHED GRADE.**  
**THE TOP 50 PAVEMENT COURSE (TYPE IIIS) WILL NOT BE**  
**CONSTRUCTED AS PART OF THIS CONTRACT. THIS CONTRACT**  
**ONLY INCLUDES 100 OF TYPE IS AND 80 OF TYPE IIS**  
**SUPERPAVE BITUMINOUS CONCRETE PAVEMENT (ITEM 490.30).**  
**PLEASE REFER TO THE ROADWAY TYPICAL SECTIONS FOR DETAILS.**



**VERMONT AGENCY OF TRANSPORTATION**

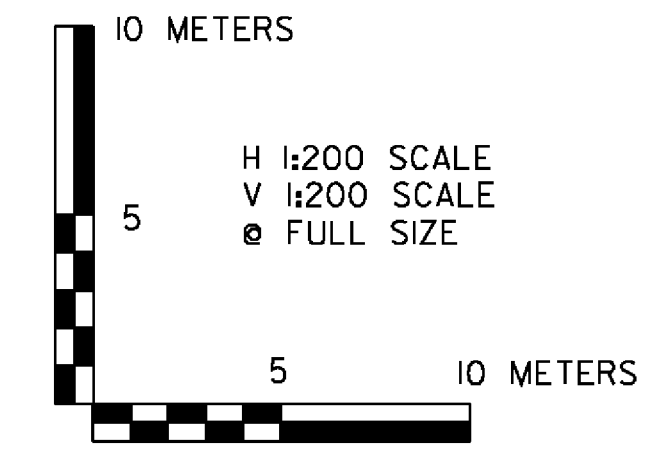

PROJECT NAME:	BENNINGTON	FILE NAME:	...\\plot_files\zd307c3xs_nb.pxf	PLOT DATE:	5/16/2011
PROJECT NUMBER:	AC NH 019-1(53)	DESIGN SUPERVISOR:	GREG EDWARDS	DRAWN BY:	STANTEC
		DESIGNED BY:	MARC FOISY	CHECKED BY:	GARY SANTY
<b>NB MAINLINE CROSS SECTIONS</b>				SHEET 317 OF 577	

w:\9531\active\9530002\transportation\drawing\contract\_3\plot\_files\zd307c3xs\_nb.pxf