



NB 9+380

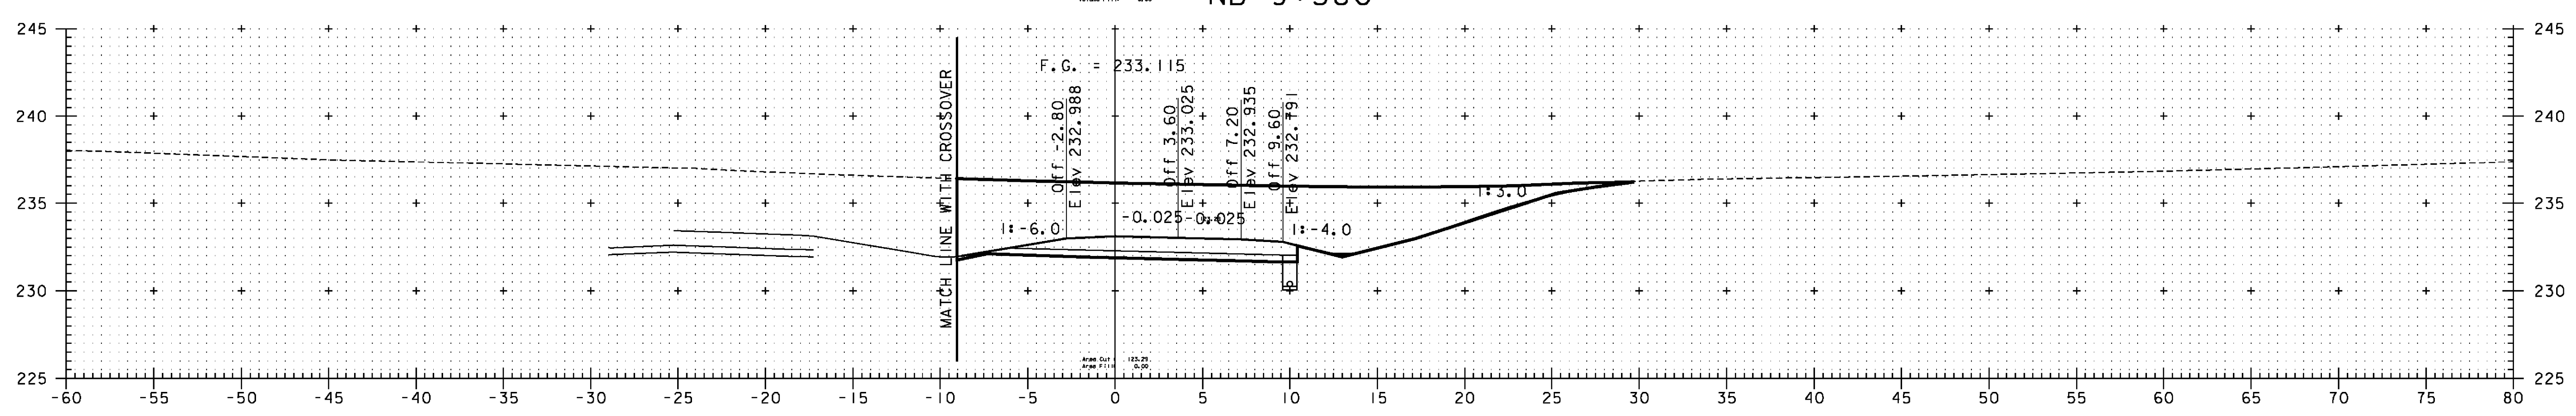

NB 9+360

SUPERSEDED  
BY  
PRECEDING  
SHEET

**NOTE:**  
ElevATIONS SHOWN ARE FOR THE ULTIMATE FINISHED GRADE.  
THE TOP 50 PAVEMENT COURSE (TYPE IIIS) WILL NOT BE  
CONSTRUCTED AS PART OF THIS CONTRACT. THIS CONTRACT  
ONLY INCLUDES 100 OF TYPE IIS AND 80 OF TYPE IIS  
SUPERPAVE BITUMINOUS CONCRETE PAVEMENT (ITEM 490.30).  
PLEASE REFER TO THE ROADWAY TYPICAL SECTIONS FOR DETAILS.

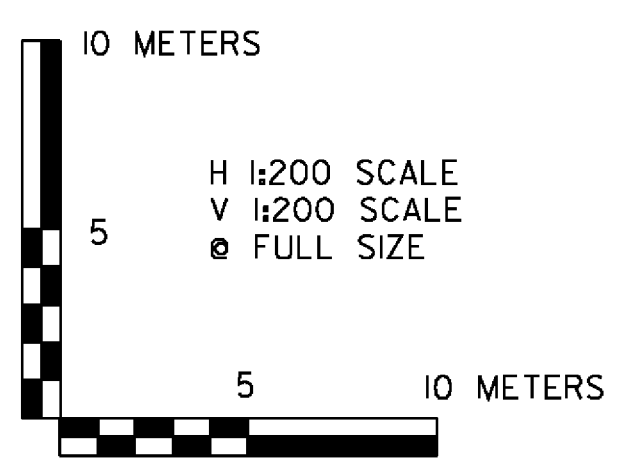

VERMONT AGENCY OF TRANSPORTATION



|                                   |                 |                    |                                  |             |            |
|-----------------------------------|-----------------|--------------------|----------------------------------|-------------|------------|
| PROJECT NAME:                     | BENNINGTON      | FILE NAME:         | ...\\plot_files\zd307c3xs_nb.p1f | PLOT DATE:  | 5/16/2011  |
| PROJECT NUMBER:                   | AC NH 019-1(53) | DESIGN SUPERVISOR: | GREG EDWARDS                     | DRAWN BY:   | STANTEC    |
| DESIGNED BY:                      | MARC FOISY      | DESIGNED BY:       | MARC FOISY                       | CHECKED BY: | GARY SANTY |
| <b>NB MAINLINE CROSS SECTIONS</b> |                 |                    | SHEET 320 OF 577                 |             |            |

v:\9531\active\9530002\transportation\drawing\contract\_3\plot\_files\zd307c3xs\_nb.p1f