


**NOTE:**  
 ELEVATIONS SHOWN ARE FOR THE ULTIMATE FINISHED GRADE.  
 THE TOP 50 PAVEMENT COURSE (TYPE IIS) WILL NOT BE  
 CONSTRUCTED AS PART OF THIS CONTRACT. THIS CONTRACT  
 ONLY INCLUDES 100 OF TYPE IS AND 80 OF TYPE IIS  
 SUPERPAVE BITUMINOUS CONCRETE PAVEMENT (ITEM 490.30).  
 PLEASE REFER TO THE ROADWAY TYPICAL SECTIONS FOR DETAILS.

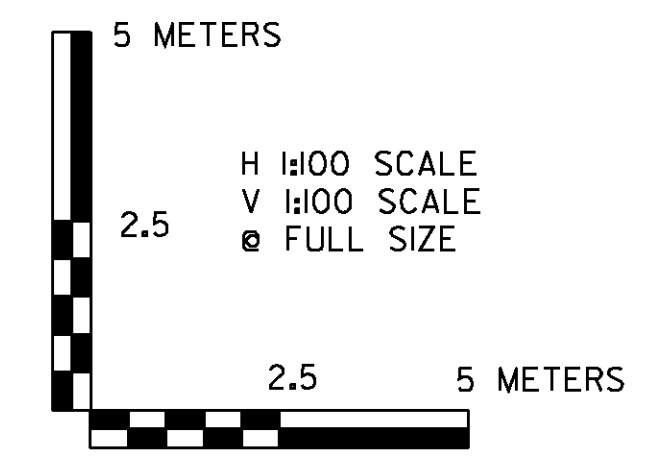

**VERMONT AGENCY OF TRANSPORTATION**

PROJECT NAME: BENNINGTON	PLOT DATE: 5/16/2011
PROJECT NUMBER: AC NH 019-(153)	DRAWN BY: STANTEC
FILE NAME: ...\\plot_files\zd307c3xs_nb.pft	CHECKED BY: GARY SANTY
DESIGN SUPERVISOR: GREG EDWARDS	SHEET 324 OF 577
DESIGNED BY: MARC FOISY	
<b>NB MAINLINE CROSS SECTIONS</b>	

V:\9531\0c1\ve\95310002\transportation\drawing\contract\_3\plot\_files\zd307c3xs\_nb.pft