


NB 9+620



VERMONT AGENCY OF TRANSPORTATION

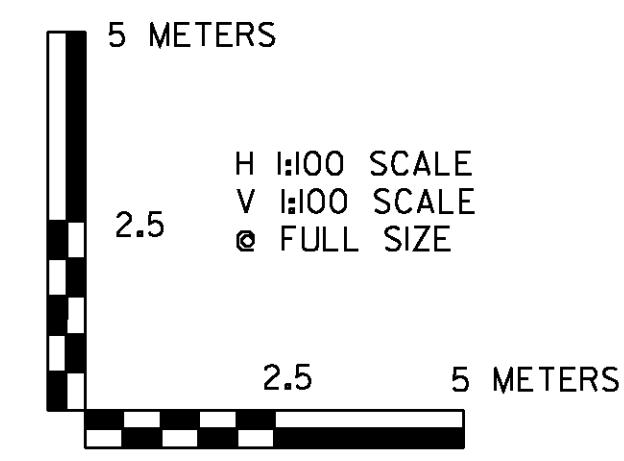

PROJECT NAME: BENNINGTON  
PROJECT NUMBER: AC NH 019-(153)

FILE NAME: ...\plot\_files\zd307c3xs\_nb.pft PLOT DATE: 5/16/2011  
DESIGN SUPERVISOR: GREG EDWARDS DRAWN BY: STANTEC  
DESIGNED BY: MARC FOISY CHECKED BY: GARY SANTY  
NB MAINLINE CROSS SECTIONS SHEET 328 OF 577

V:\953\active\9530002A\transportation\drawing\contract\_3\plot\_files\zd307c3xs\_nb.pft