


**NOTE:**  
 ELEVATIONS SHOWN ARE FOR THE ULTIMATE FINISHED GRADE.  
 THE TOP 50 PAVEMENT COURSE (TYPE IIIS) WILL NOT BE  
 CONSTRUCTED AS PART OF THIS CONTRACT. THIS CONTRACT  
 ONLY INCLUDES 100 OF TYPE IS AND 80 OF TYPE IIS  
 SUPERPAVE BITUMINOUS CONCRETE PAVEMENT (ITEM 490.30).  
 PLEASE REFER TO THE ROADWAY TYPICAL SECTIONS FOR DETAILS.

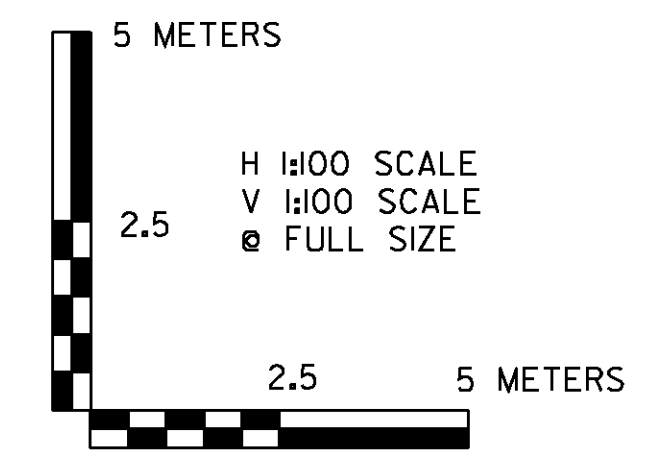

VERMONT AGENCY OF TRANSPORTATION	
	PROJECT NAME: BENNINGTON
	PROJECT NUMBER: AC NH 019-(153)
FILE NAME: ...\plot_files\zd307c3xs_xo.pxf	PLOT DATE: 5/16/2011
DESIGN SUPERVISOR: GREG EDWARDS	DRAWN BY: STANTEC
DESIGNED BY: MARC FOISY	CHECKED BY: GARY SANTY
<b>CROSSOVER CROSS SECTIONS</b>	SHEET 334 OF 577

V:\9513\active\95130002\transportation\drawing\contract\_3\plot\_files\zd307c3xs\_xo.pxf