


NOTE:
 ELEVATIONS SHOWN ARE FOR THE ULTIMATE FINISHED GRADE.
 THE TOP 50 PAVEMENT COURSE (TYPE IIIS) WILL NOT BE
 CONSTRUCTED AS PART OF THIS CONTRACT. THIS CONTRACT
 ONLY INCLUDES 100 OF TYPE IS AND 80 OF TYPE IIS
 SUPERPAVE BITUMINOUS CONCRETE PAVEMENT (ITEM 490.30).
 PLEASE REFER TO THE ROADWAY TYPICAL SECTIONS FOR DETAILS.



VERMONT AGENCY OF TRANSPORTATION

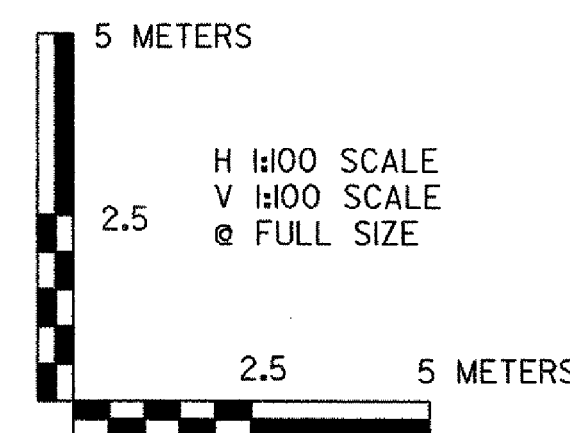

PROJECT NAME:	BENNINGTON	PLOT DATE:	5/19/2007
PROJECT NUMBER:	AC NH 019-1(53)	DRAWN BY:	STANTEC
FILE NAME:	... \plot_files\zd307c3xs_xo.pxf	CHECKED BY:	GARY SANTY
DESIGN SUPERVISOR:	GREG EDWARDS	SHEET	336 OF 577
DESIGNED BY:	MARC FOISY	CROSSOVER CROSS SECTIONS	