


**NOTE:**  
 ELEVATIONS SHOWN ARE FOR THE ULTIMATE FINISHED GRADE.  
 THE TOP 50 PAVEMENT COURSE (TYPE IIIS) WILL NOT BE  
 CONSTRUCTED AS PART OF THIS CONTRACT. THIS CONTRACT  
 ONLY INCLUDES 100 OF TYPE IS AND 80 OF TYPE IIS  
 SUPERPAVE BITUMINOUS CONCRETE PAVEMENT (ITEM 490.30).  
 PLEASE REFER TO THE ROADWAY TYPICAL SECTIONS FOR DETAILS.



**VERMONT AGENCY OF TRANSPORTATION**

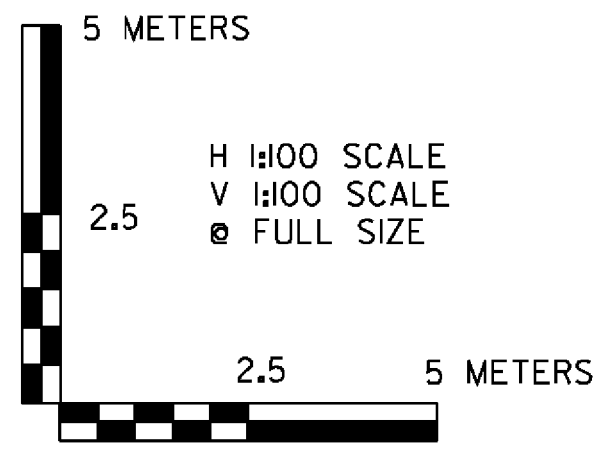

PROJECT NAME:	BENNINGTON	FILE NAME:	...\\plot_files\zd307c3xs_xo.pxf	PLOT DATE:	5/16/2011
PROJECT NUMBER:	AC NH 019-1(53)	DESIGN SUPERVISOR:	GREG EDWARDS	DRAWN BY:	STANTEC
DESIGNED BY:	MARC FOISY	CHECKED BY:	GARY SANTY	SHEET 343 OF 577	
<b>CROSSOVER CROSS SECTIONS</b>					

w:\953\active\9530002\transportation\drawing\contract\_3\plot\_files\zd307c3xs\_xo.pxf