


NOTE:
ELEVATIONS SHOWN ARE FOR THE ULTIMATE FINISHED GRADE.
THE TOP 50 PAVEMENT COURSE (TYPE IIIS) WILL NOT BE
CONSTRUCTED AS PART OF THIS CONTRACT. THIS CONTRACT
ONLY INCLUDES 100 OF TYPE IS AND 80 OF TYPE IIS
SUPERPAVE BITUMINOUS CONCRETE PAVEMENT (ITEM 490.30).
PLEASE REFER TO THE ROADWAY TYPICAL SECTIONS FOR DETAILS.

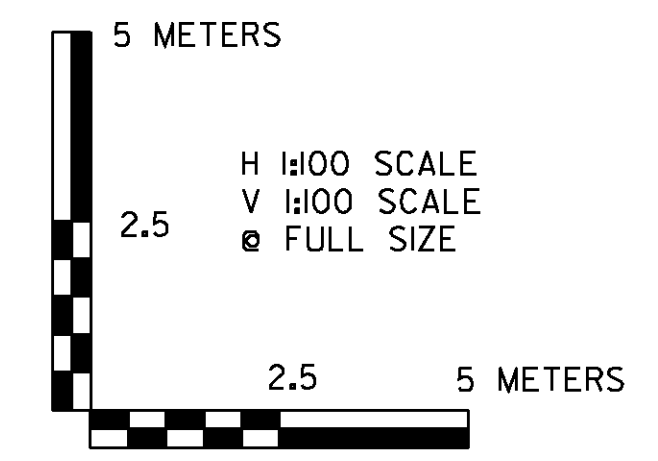

VERMONT AGENCY OF TRANSPORTATION

PROJECT NAME: BENNINGTON	PLOT DATE: 5/16/2011
PROJECT NUMBER: AC NH 019-(153)	DRAWN BY: STANTEC
FILE NAME: ...\\plot_files\zd307c3xs_xo.pft	DESIGNED BY: MARC FOISY
DESIGN SUPERVISOR: GREG EDWARDS	CHECKED BY: GARY SANTY
CROSSOVER CROSS SECTIONS	SHEET 344 OF 577

V:\9531\active\ve\95310002\transportation\drawing\contract_3\plot_files\zd307c3xs_xo.pft